Sewers o.k.
Jh.

KILBOURNE AVE. 60' WD.
FROM LEROY TO HAYES

(Est. 9-12-39)

Topo 66

B-4140

CLASS "B" - 8" MAC. + 2½" OIL AGG.
FORCED PAVING - C.C. PROC. 7-5-39

Water [illegible]
7-26-39

DEPARTMENT OF PUBLIC WORKS
CITY ENGINEER'S OFFICE
DETROIT, MICH.

SCALE: HOR. 1" = 100' VER. 1" = 10'	DATE 10 22 31
PLAN DRAWN BY	L. R.
PLAN CHECKED BY F.M. 10-11-40	W. C.
PROFILE DRAWN BY	L. R.
COMPUTATIONS MADE BY	
" CHECKED BY	
GRADE ESTABLISHED BY	V. G.

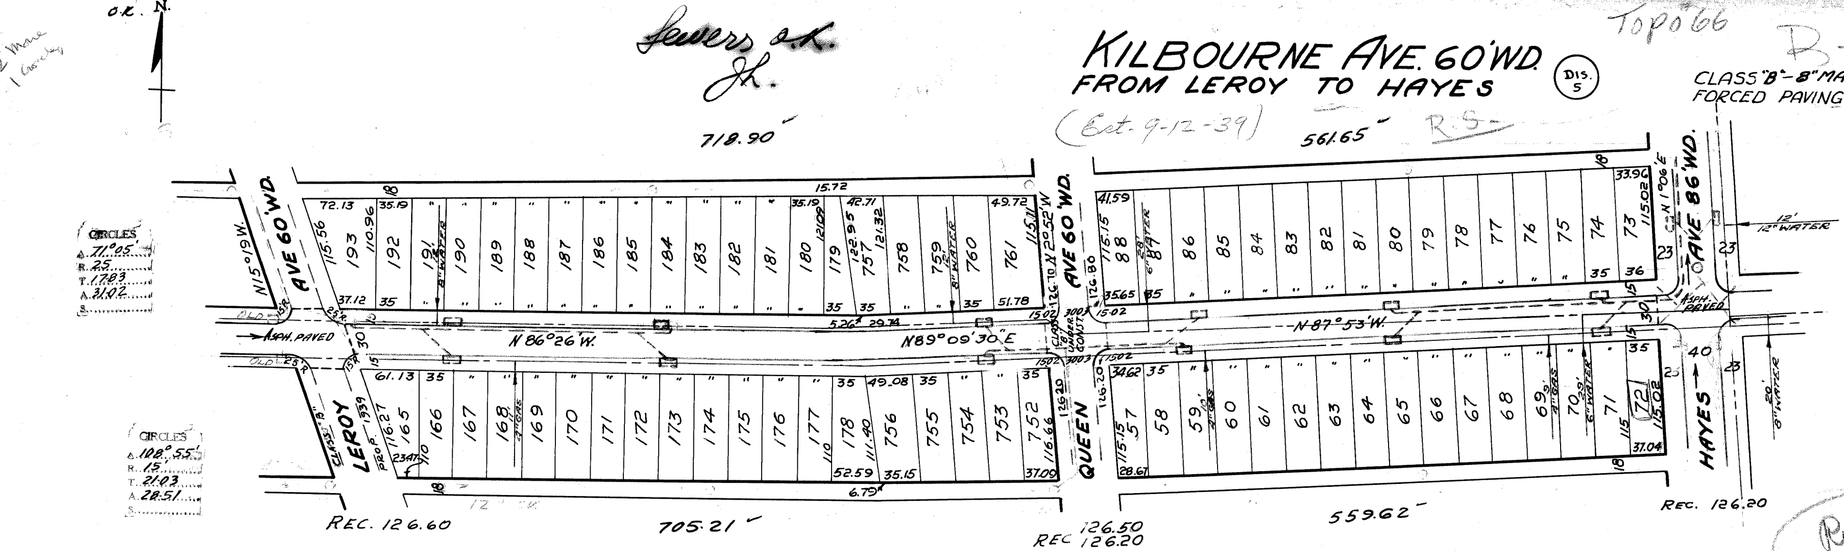

B 994 P 36	LOTS	CITY
Excavation		
N. C. Straight		
Old Curb Reset		
N. C. Rnd. Circles by Contr.		
Paving		
" Concrete Base		
Curb Concrete		
Pat. Stone		
Concr. Header Sq. Yds		

DRAINAGE O.K.
SUMP MANHOLE
BASINS BY W.P.A.
FIELD INVESTIGATED JUNE, 1939.
BLACK TOP SURFACE

Rush To
R. REUM

LOTS 2545.38 ½ = 1272.69
CITY
TOTAL 2545.38 ½ = 1272.69

B.M. TOP OF HYD. S.W. COR. KILBOURNE & HAYES → 129.67
B.M. HIGHEST PART OF FIG. O IN W. END OF LOT 80
N.S. KILBOURNE → 126.60
B.M. SPK. IN S.S. LIGHT POLE N.W. COR. KILBOURNE & QUEEN → 127.38
B.M. SPK. IN N.S. LT. POLE S.S. KILBOURNE 418' E. OF LEROY → 127.77
B.M. SPK. IN S.S. LT. POLE N.W. COR. KILBOURNE & LEROY → 127.61

TO FIELD ENGINEER
CE BASINS IN SIDE DRIVES OR ON LOT LINE
MATION AS TO LOCATIONS OF BASINS TO
OFFICE PAVING DEPARTMENT.

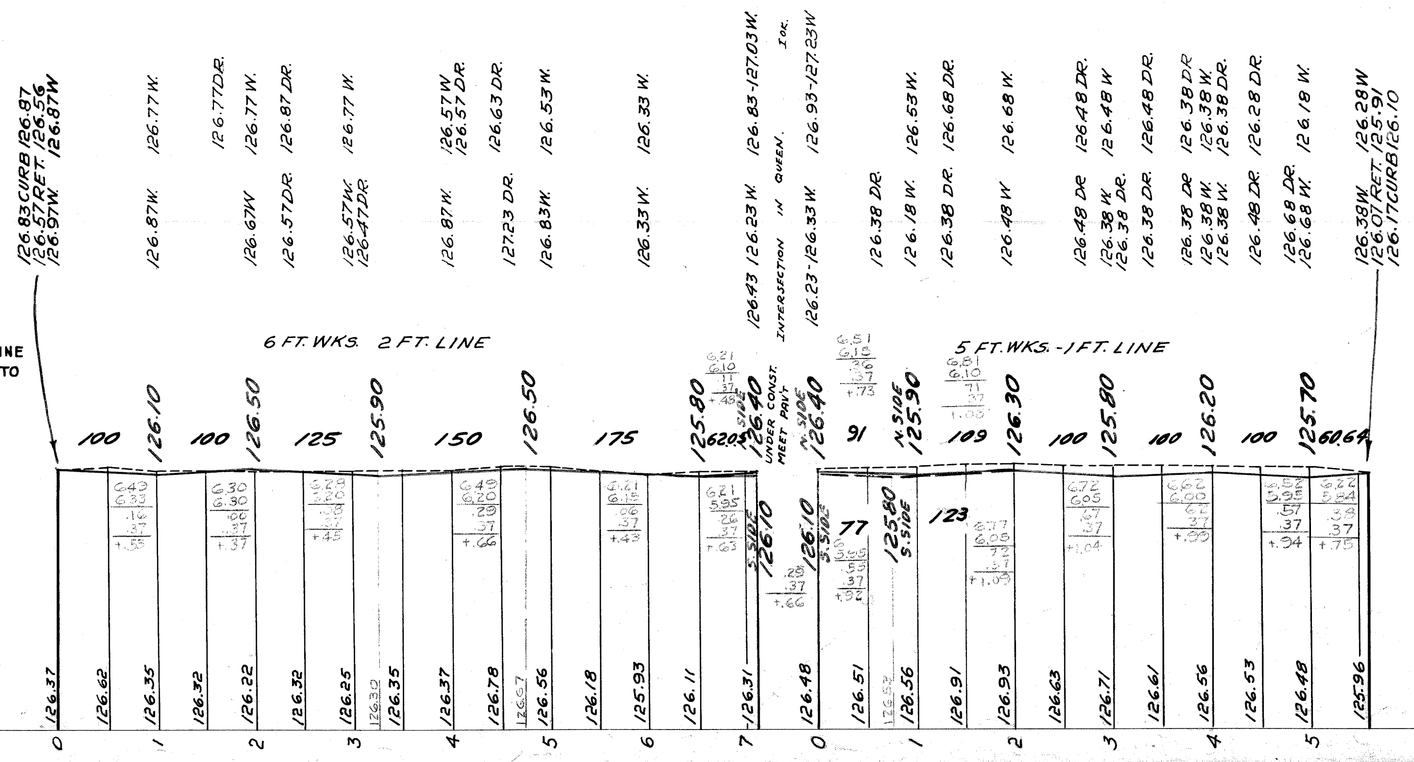

DRAINAGE COMPLETED.....
PAVING COMPLETED 9/14/40

EXISTING POOLS & BASINS
NEW POOLS

DESIGNED BY	V. Guillemoty	APPROVED
DRAWN BY		W. J. Wallace ENGINEER OF STREETS
TRACED BY		
CHECKED BY	V. Guillemoty	Martin R. Fisher ASST CITY ENGINEER

94718