LIBERAL AVE. 60 FT

SCHOENHERR TO GRATIOT

CLASS B-PAVG 42'6" OIL MAC. 30' wide

T.OPO #94 D15

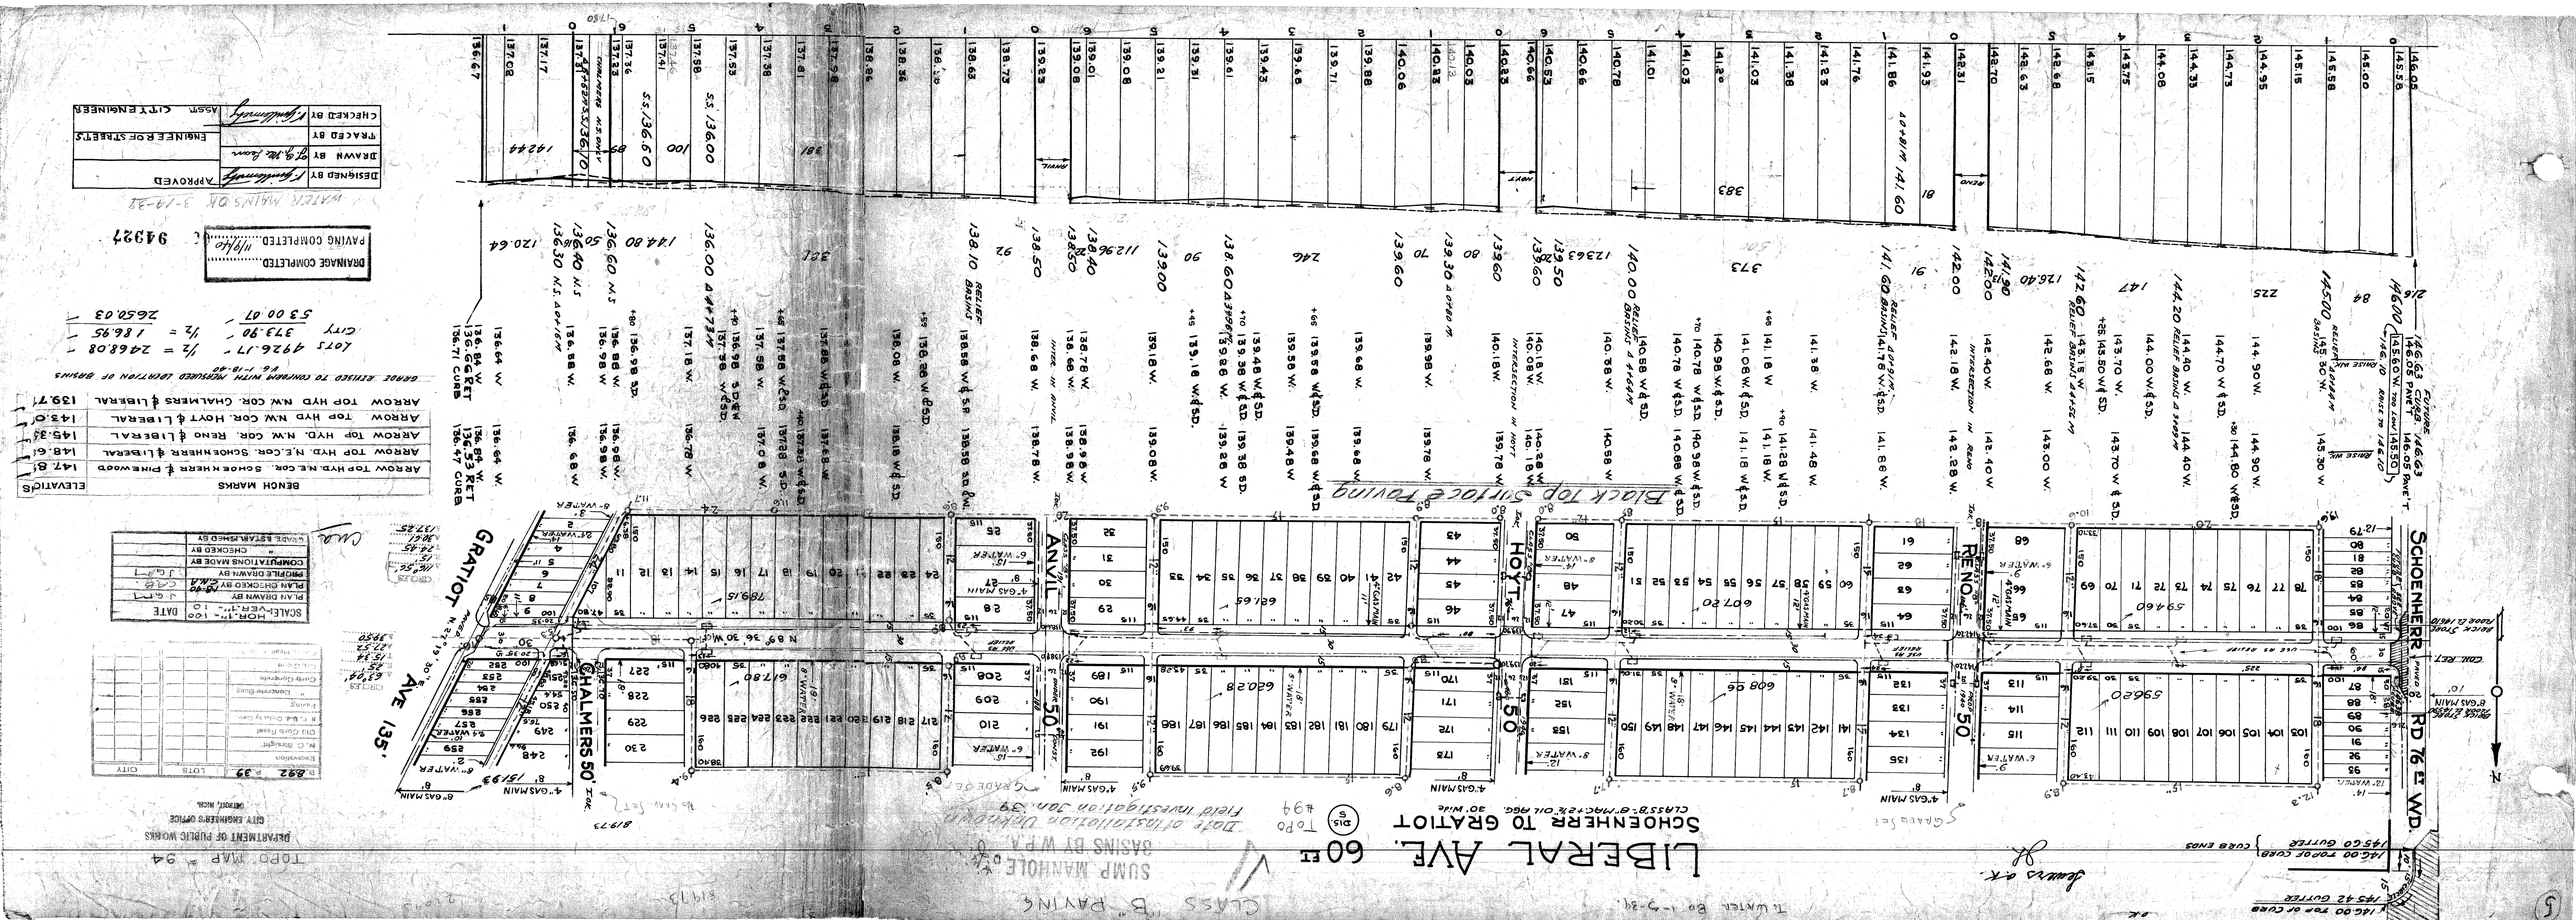
SCHOENHERR RD 76 FT WD.
HOYT
RENO
ANVIL
GRATIOT
CHALMERS 50'
Block Top Surface Paving
CLASS B PAVING
SUMP MANHOLE
BASINS BY W.P.A.
CLASS "B" PAVING
T. WATER Bo 1-7-31
DEPARTMENT OF PUBLIC WORKS
CITY ENGINEER'S OFFICE
DETROIT, MICH.
DRAINAGE COMPLETED
PAVING COMPLETED
9493?
WATER MAINS DR 3-19-31
DESIGNED BY
DRAWN BY
TRACED BY
CHECKED BY
ASST. CITY ENGINEER
ENGINEER OF STREETS
APPROVED
BENCH MARKS
ELEVATIONS
ARROW Top HYD. N.E. Cor. SCHOENHERR & PINEWOOD 147.81
ARROW Top HYD. N.E.Cor. SCHOENHERR & LIBERAL 148.61
ARROW Top HYD. N.W. Cor. RENO & LIBERAL 145.34
ARROW Top HYD N.W. Cor. HOYT & LIBERAL 143.61
ARROW Top HYD N.W. COR. CHALMERS & LIBERAL 139.71
Lots 4926.17 ' ½ = 2468.08 '
City 373.90 ' ½ = 186.95 '
53 00 07 ' 2652.03 '
SCALE-VER. 1"= 10 DATE
PLAN DRAWN BY J.G.M.
PLAN CHECKED BY C.A.B.
COMPUTATIONS MADE BY J.G.M.
PROFILE DRAWN BY "
CHECKED BY "
SCALE: HOR. 1"= 100 VER. 1"= 10
B. 892 P. 39 LOTS CITY
Chg. Grade Elev.
Elevation
Location
N.C. Straight
N.C. Curve Point
N.C. Curve Tangent
Chg. Curve Elev.
Chg. Grade Elev.
Elevation
Location
Remarks
