DATE	REVISIONS
	OLD MAP 10-16-35

SUPPLEMENTARY DETAILS			
~~C-325~~	C-524	C-733	~~C-938~~
C-326A	~~C-585~~	~~C-739~~	C-1608
C-327	~~C-586~~	~~C-739A~~	C-1783
~~C-390~~	C-587	C-7398	

C-4378 THRU C-4395

BEFORE STARTING CONSTRUCTION
CONTRACTOR MUST CHECK WITH UTILITIES FOR LOCATIONS OF EXISTING STRUCTURES WHETHER OR NOT INDICATED ON PLANS.

SCALE	
LOTS & ALLEYS	1" = 100'
STREET WIDTH	1" = 60'
VERTICAL	1" = 2'
DRAINAGE COMPLETED	
PAVING COMPLETED	

QUANTITIES		ESTIMATED LOTS	ESTIMATED CITY
EXCAVATION	CU. YDS.		
NEW CURB	LIN. FT.		
PAVING	SQ. YDS.		
"	"		
TEST CORES			
SIDEWALK	SQ. FT.		
MANHOLES	ADJUST		
	CONSTRUCT		
BASINS #	ADJUST		
	CONSTRUCT		
SEWER-12"	LIN. FT.		

PETITION NO.	2886	PETITION DATE	10-28-58
ASSIGNMENT NO.	325-CW-14	GROUP NO.	
BOOK NO.	1838 PG. 51-53	LEVEL DATE	1-18-60
LOTS 2L	957.68	LENGTH	478.84
CITY 2L	20.00	LENGTH	10.00
TOTAL	977.68	LENGTH	488.84
DATE OF DRAW'G.	1-21-60		

	MADE BY	CHECKED BY
PLAN	SHARP	
PROFILE	SHARP	
GRADE	G.E.B.	
ESTIMATE		
SEWER APPROVED	Peter Schaefer	
FINAL CHECK		
APPROVED	Erickson	
	Bingham	
	ENGINEER OF STREETS	
	CITY ENGINEER	

INDEX NO.	TOPO NO.	INDEXED
15	81	

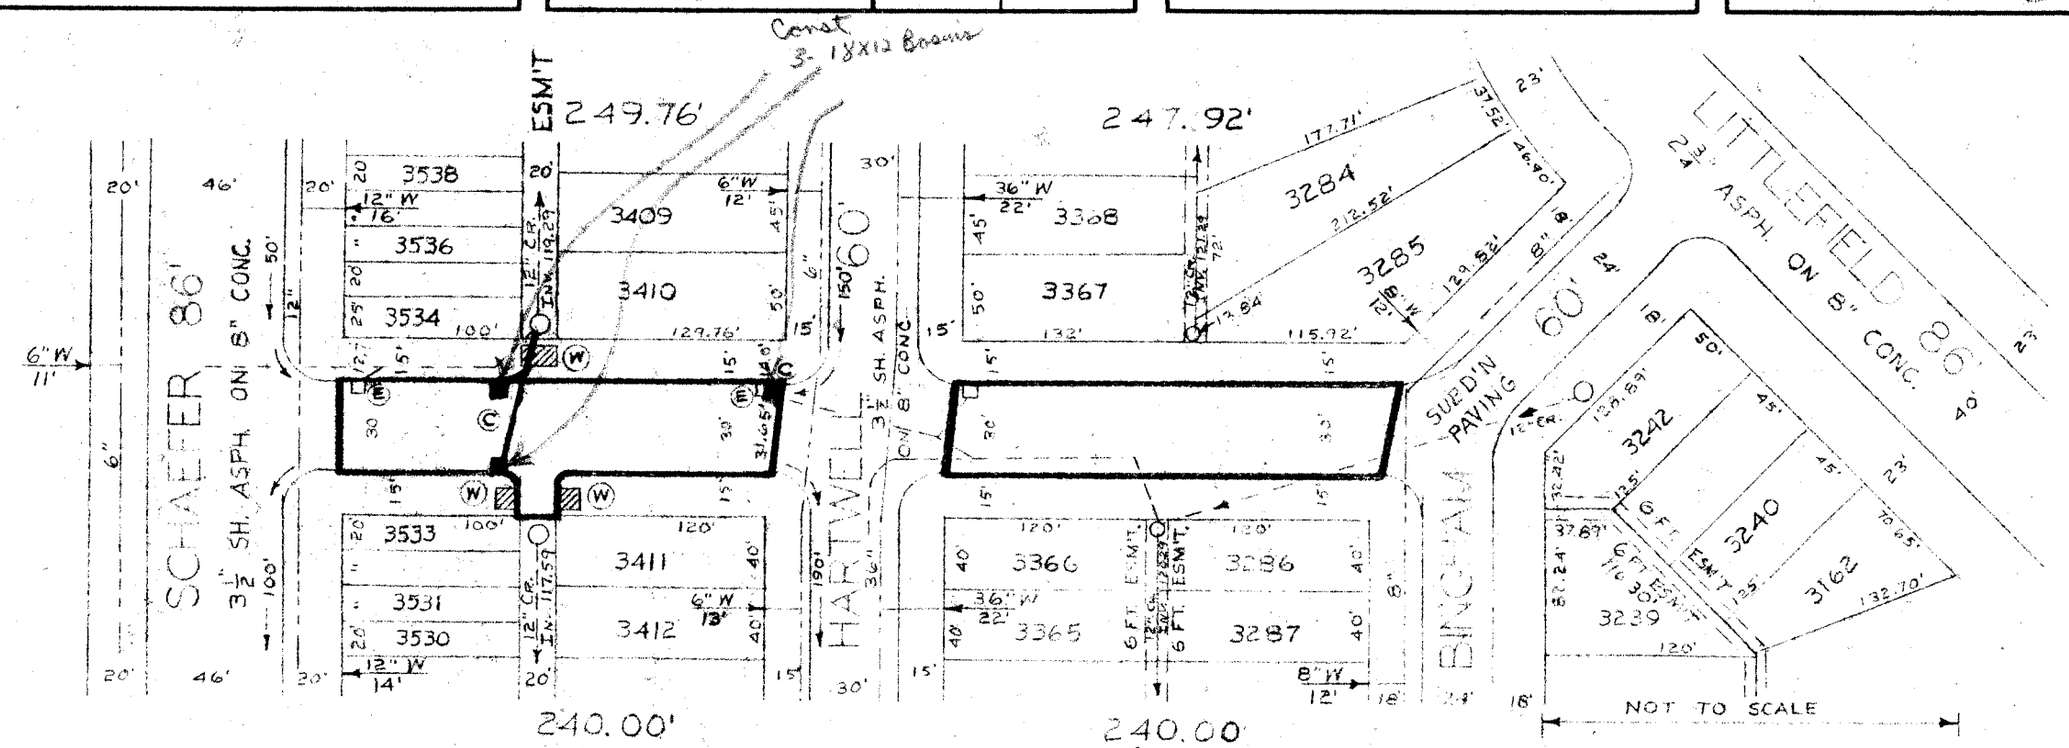

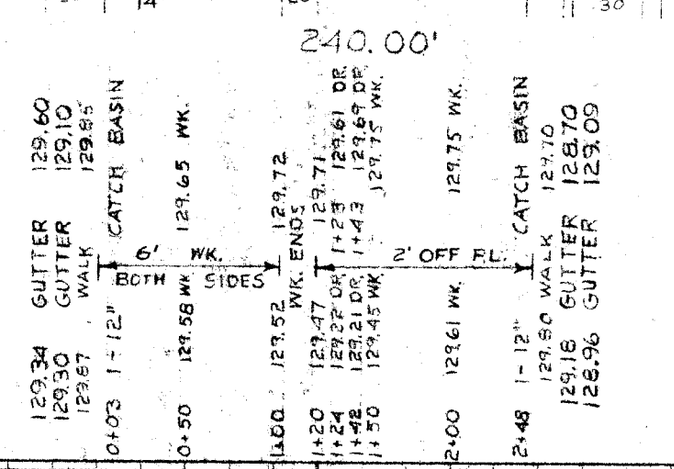

CONTRACT NO. P.W. DRAINAGE ONLY

STREET PAVING PLAN
CITY OF DETROIT

DEPARTMENT OF PUBLIC WORKS — CITY ENGINEERS OFFICE

NAME OF STREET MACKENZIE

FROM E.P.L. SCHAEFER

TO W.P.L. BINGHAM

SHEET 1 OF 1 SHEETS

TYPE OF PAVEMENT 8 6 8 ONE COURSE CONCRETE-INTEGRAL CURB 30 FT. WD.
8" UNIFORM AT STREET INTERSECTION EXCEPT AS NOTED

JOHN LUKESICH 201-4721 PET # 2886 10-28-58

BENCH MARKS **ELEV.**

P.L.B.M. # 82-254A N.E. COR. JOY & LITTLEFIELD	130.186 REC.
P.L.B.M. # 82-254 N.E. COR. JOY & SCHAEFER	130.784 REC.
C.B.M. ARROW ON HYD. OPPOSITE # 8591 HARTWELL	133.78
C.B.M. ARROW ON HYD. N.W. COR. HARTWELL & MACKENZIE	132.58
C.B.M. ARROW ON HYD. N.E. COR. SCHAEFER & MACKENZIE	132.68

NOTE:
FOR SYMBOLS (A) ETC. SEE STD. DET. DWG. C-4378

HORIZONTAL CONTROL
CROSSES CUT IN WALK 5' NORTH OF S.P.L. MACKENZIE AT E.P.L. SCHAEFER AND W.P.L. HARTWELL.

MAY 17 '60 AM

CITY OF DETROIT SEWER DIVISION
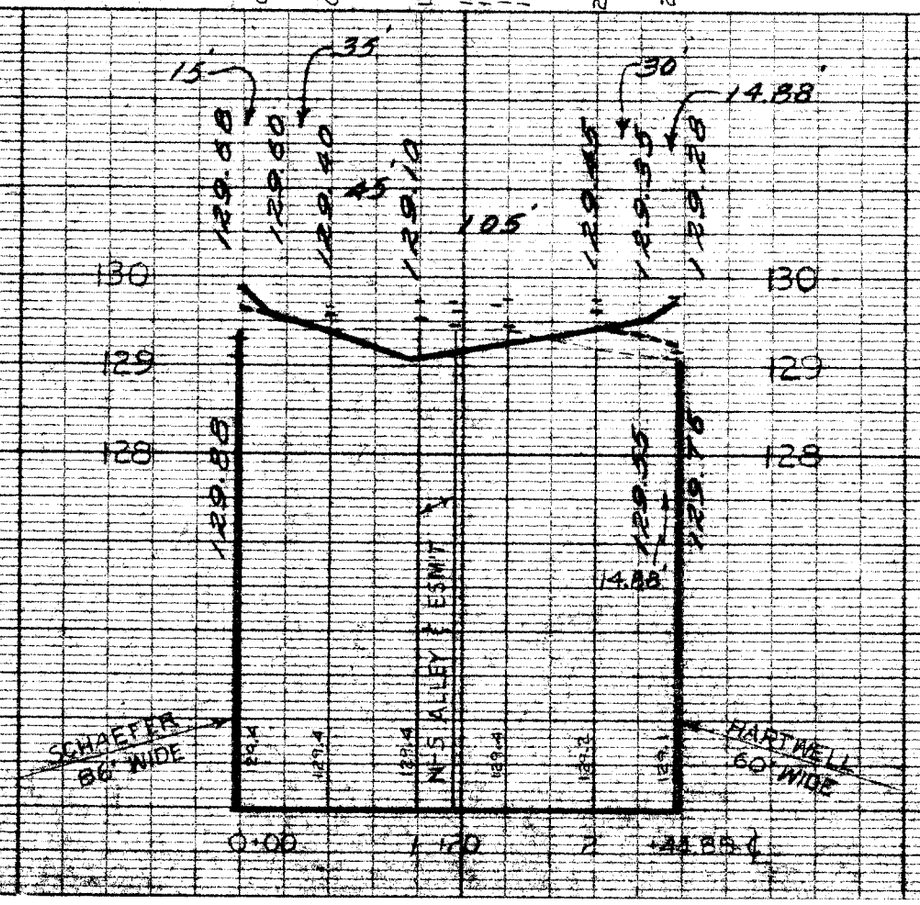
POSTED 9-23-60