DEPARTMENT OF PUBLIC WORKS DETROIT

CITY ENGINEER'S OFFICE --- DIVISION OF PAVING DESIGN

STREET PAVING PLAN

SEWER	
INDEXED	
REVISIONS	11-5-42
DRAINAGE E. & W. OF BOULDER AVE.	

JOB NO.		PROGRESS	
BLUE PRINT ISSUED FOR:	DATE	START	FINISH
GRADE ONLY			
CATCH BASINS			
PAVING-CLASS-			
DEPT. OF WATER SUPPLY			
GAS CO.			

QUANTITIES	LOTS	CITY	LOTS	CITY
EXCAVATION				
STRAIGHT CURB NEW				
OLD CURB RESET				
CIRCULAR CURB				
PAVING				
CONCRETE BASE				

HOR. SCALE 1" = 100' 1" = 50'	BOOK 1381 PAGE 61-72		
VER. SCALE 1" = 2'	DATE F.B. 6-8-42 MAP 7-31-42		
PLAN S.S.	PROFILE S.S.	COMPUTED	
CHECKED	GRADE S.S.	CHECKED R3	
LOTS 2L	1 899 82	LENGTH	949 91
CITY 2L	322 30	LENGTH	161 15
TOTAL 2L	2 222 12	LENGTH	1 111 06
		LOTS	CITY
COST ADVERTISING BLANKS			
COST INSPECTION			

DESIGNED BY	S. Sadowski
DRAWN BY	S. Sadowski
TRACED BY	
CHECKED BY	[illegible] R3
APPROVED	[illegible]
ENGINEER OF STREETS	
CITY ENGINEER	

CARD NO

INDEX NO	TOPO NO
38	95

RECORD NO

NAME OF STREET MADDELEIN AVE.

FROM E.P.L. OF REDMOND AVE.

TO ~~88' E. OF W.P.L. OF KELLY RD.~~

TYPE OF PAVEMENT ~~6" ONE CO. CONCRETE~~ WIDTH 30' & 36'

NUMBER OF SHEETS 1

SHEET NO 1

Louis Rose - 19,401 Kelly Rd.
Letter from E. Proctor 5/26/42

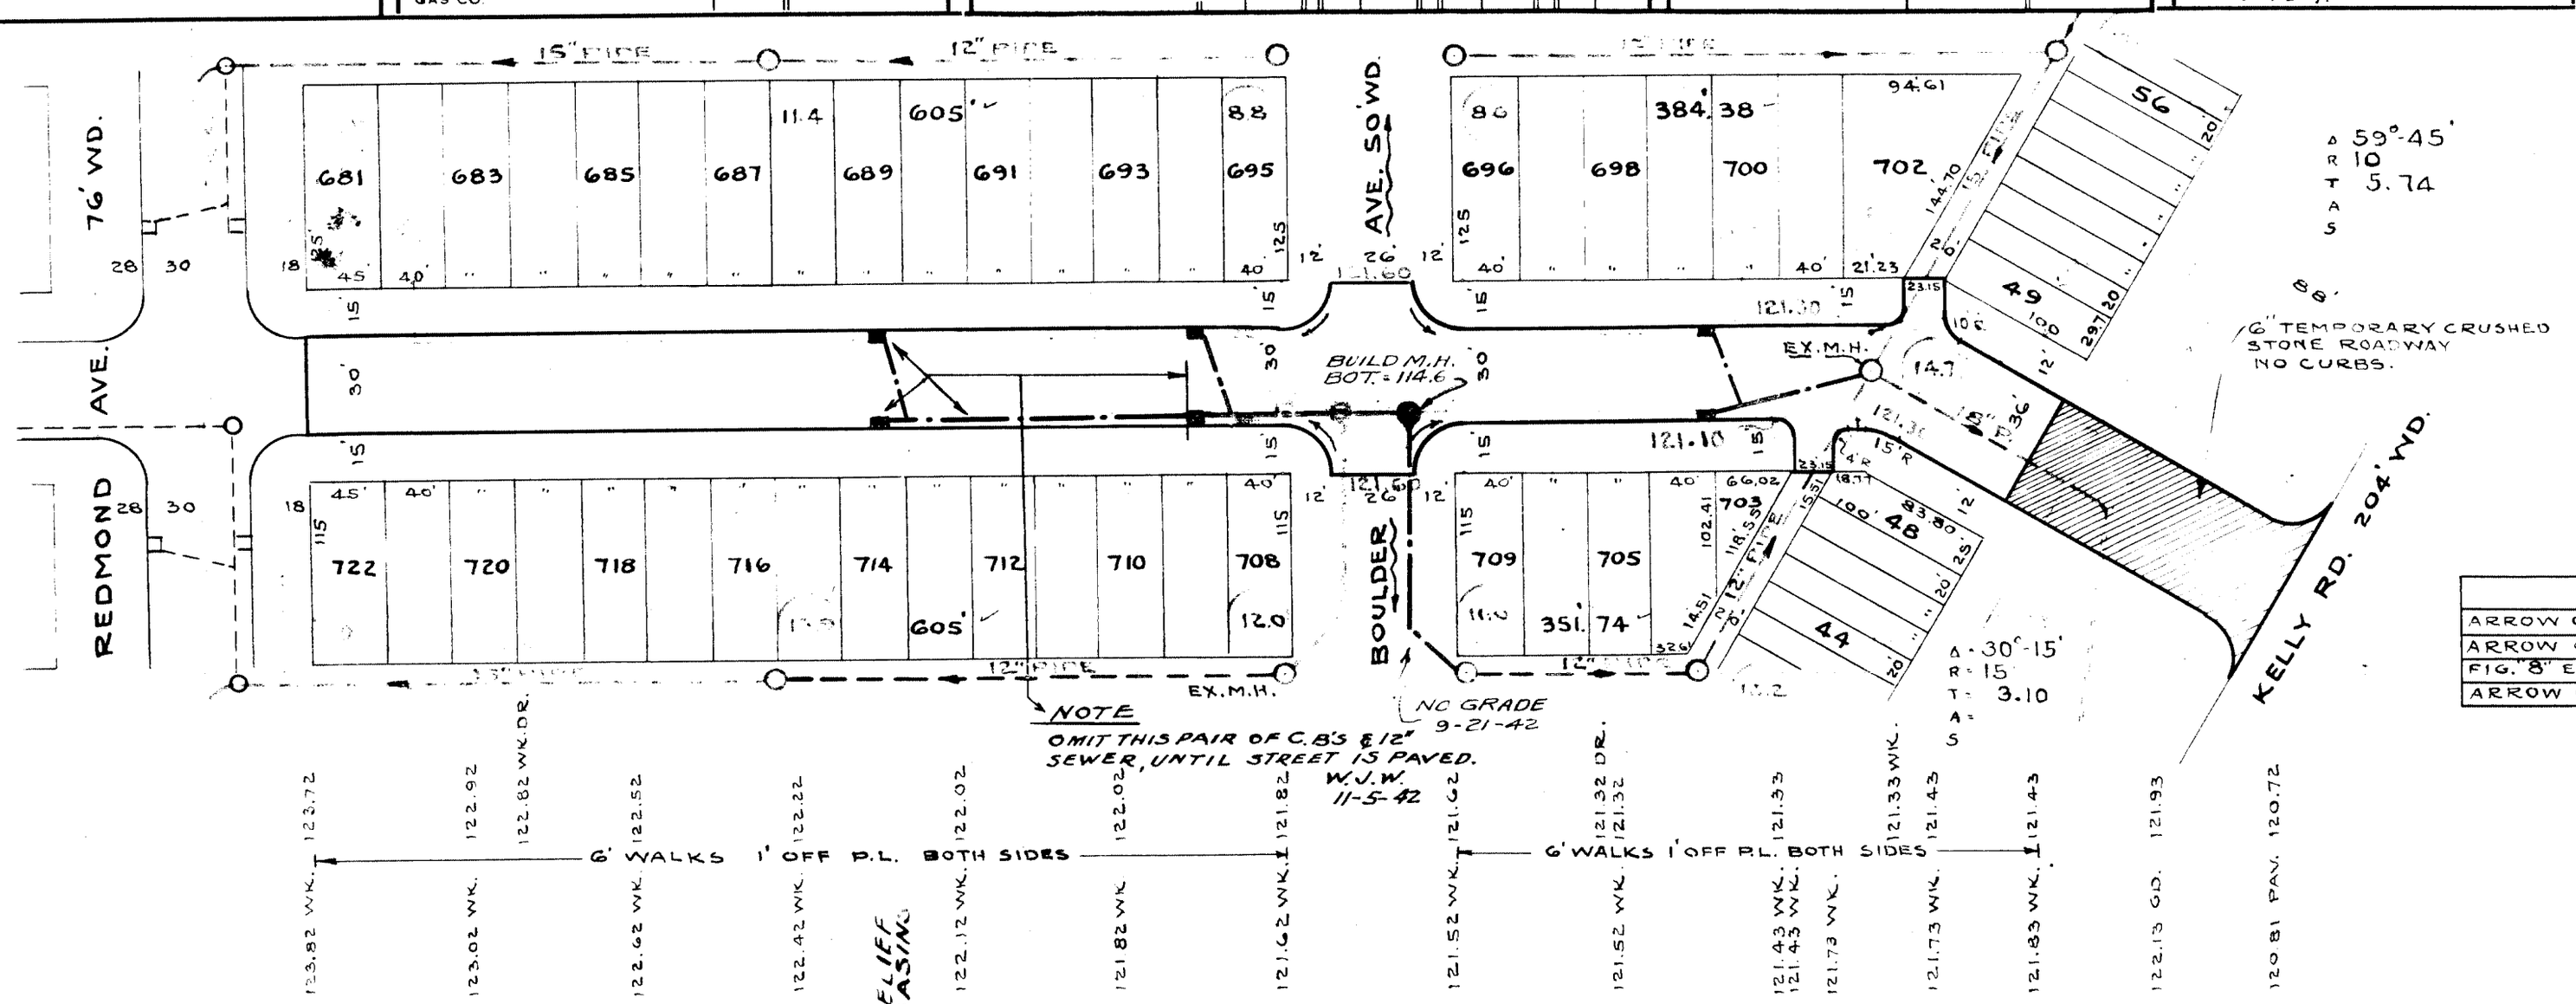

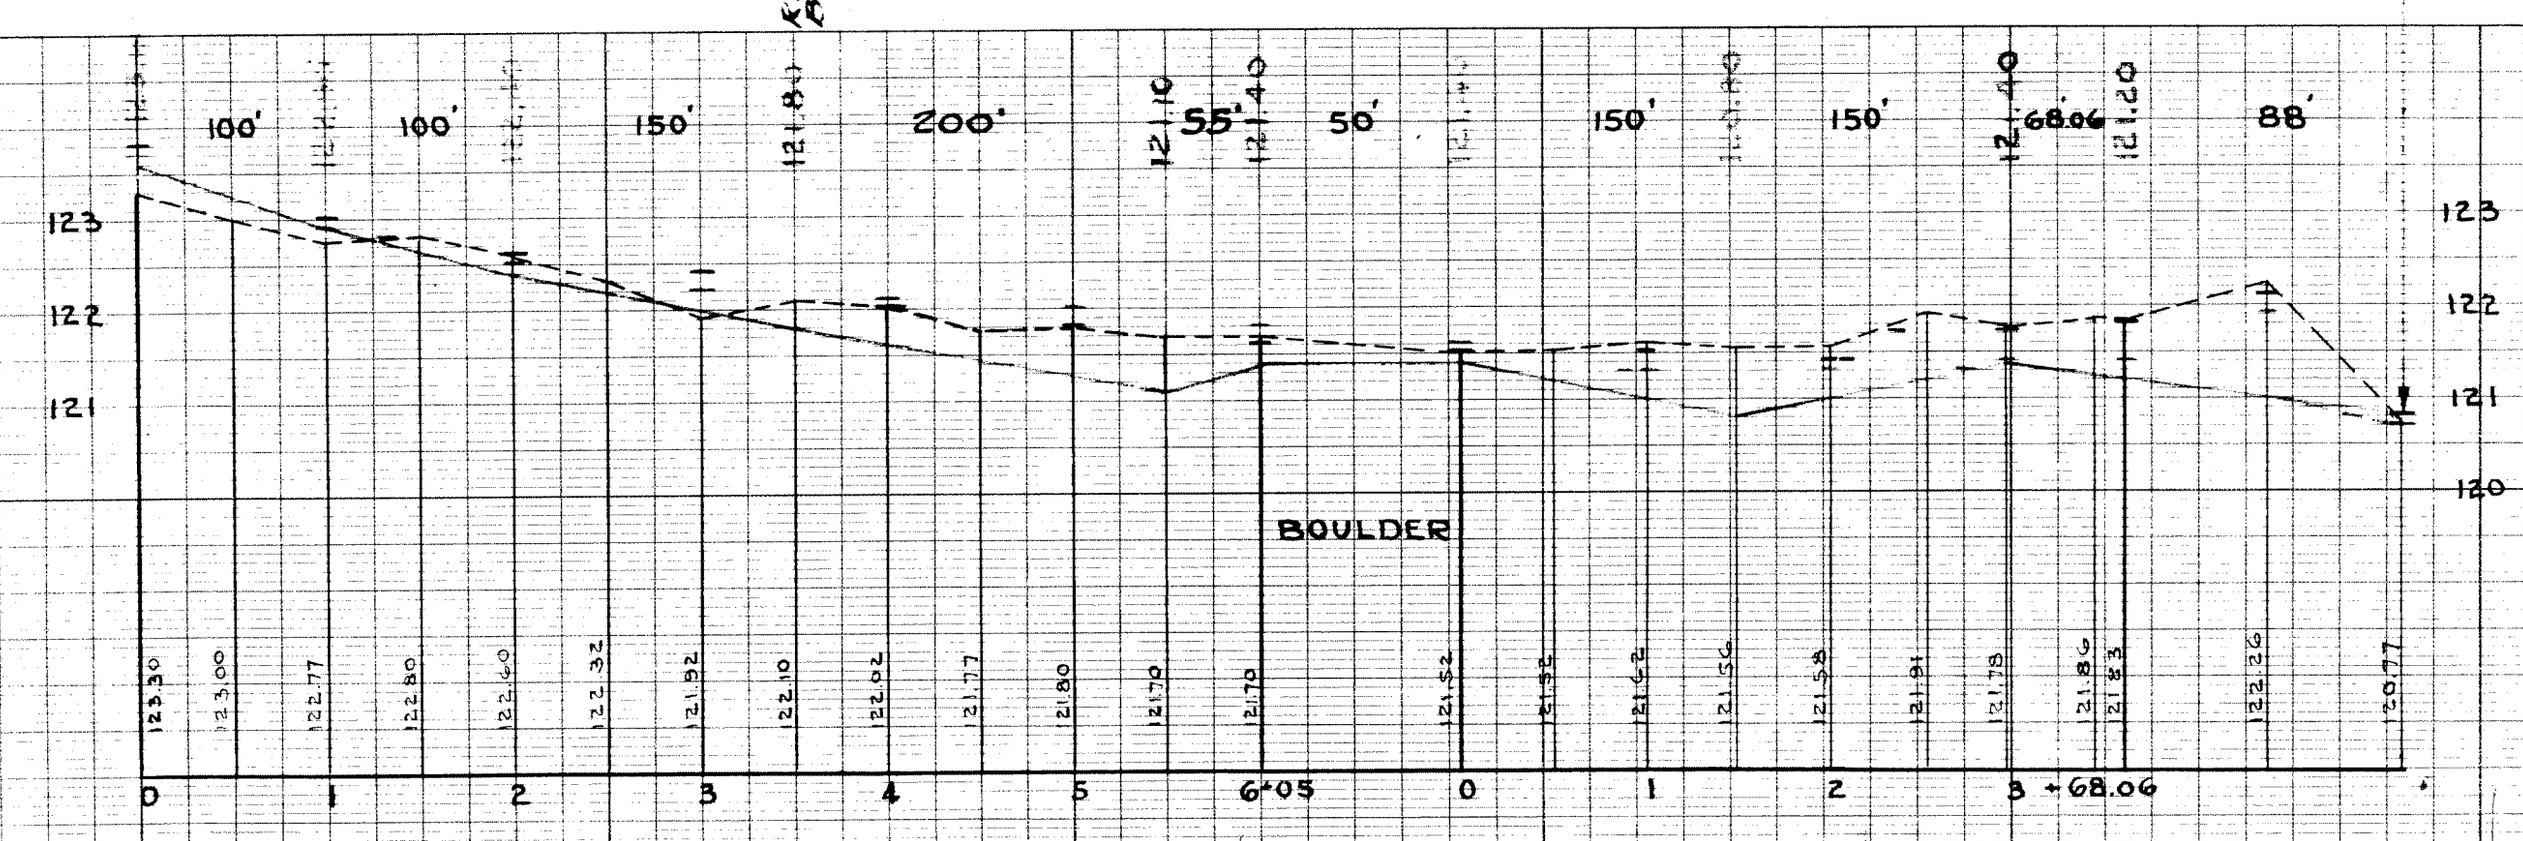

BENCH MARKS	ELEV.
ARROW ON HYD. N.E. COR. OF REDMOND & MADDELEIN	126.77
ARROW ON HYD. N.W. COR. OF BOULDER & MADDELEIN	124.64
FIG. "8" E SIDE OF LOT # 698 N. WALK OF MADDELEIN 120' OR. OF BOULDER	121.46
ARROW ON HYD. N.W. COR. OF KELLY & MADDELEIN	124.53