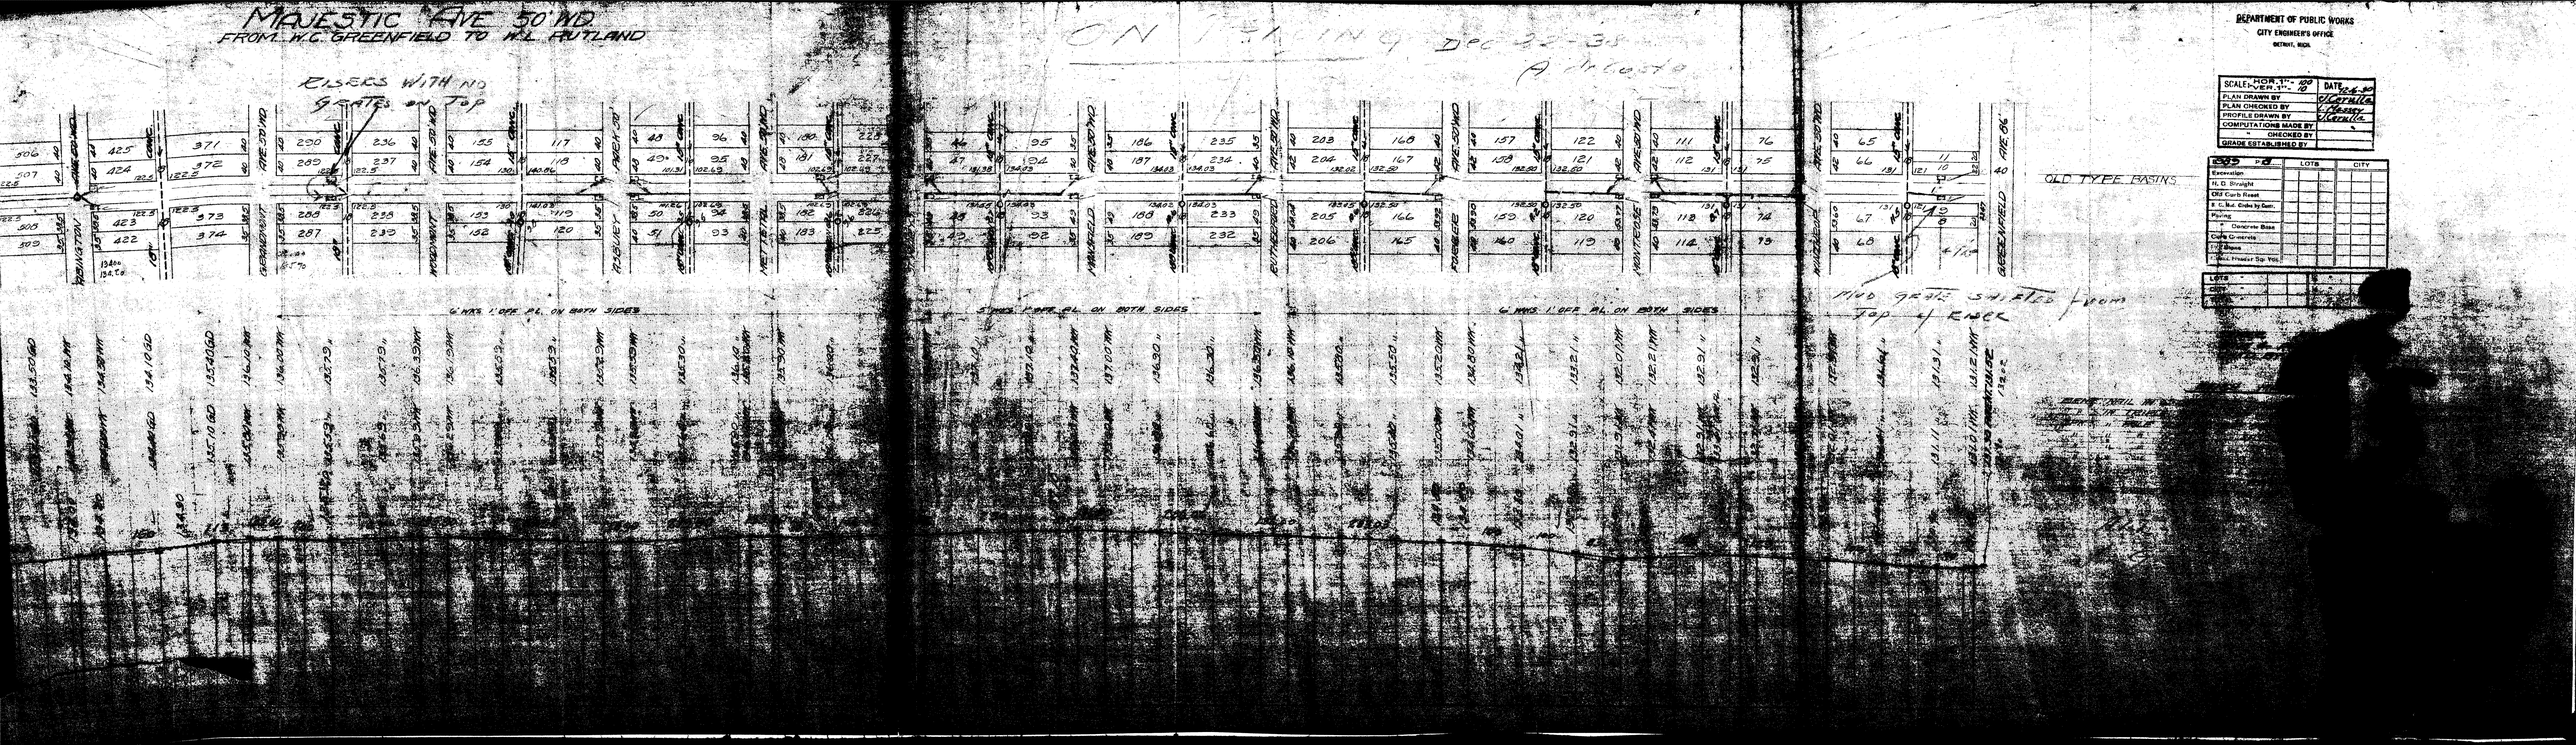
MAJESTIC AVE 50' WD.
FROM W.C. GREENFIELD TO W.L. RUTLAND
RISERS WITH NO GRATES ON TOP
ON PAVING Dec 22-38
OLD TYPE BASINS
MUD GRATE SHIFTED FROM TOP of RISER
6' WKS 1' OFF PL. ON BOTH SIDES
5' WKS 1' OFF PL. ON BOTH SIDES
6' WKS 1' OFF PL. ON BOTH SIDES
ABINGTON
GRANDMONT
WOODMONT
ASBURY
METTETOL
MANSFIELD
RUTHERFORD
FORBLER
MONTROSE
WINDSOR
GREENFIELD
DEPARTMENT OF PUBLIC WORKS
CITY ENGINEER'S OFFICE
DETROIT, MICH.
SCALE HOR. 1" = 100 VER. 1" = 10
DATE 12-6-40
PLAN DRAWN BY
PLAN CHECKED BY
PROFILE DRAWN BY
COMPUTATIONS MADE BY
CHECKED BY
GRADE ESTABLISHED BY
LOTS
CITY
Excavation
N. C. Straight
Old Curb Reset
E. C. Mod. Curbs by Contr.
Paving
Concrete Base
Curb Concrete
Fill Stone
Concr. Frontier Sq. Yds.