SEWER
REVISIONS

SUPPLEMENTARY DETAILS			
C-324A	C-390	C-587	C-739B
C-325	C-524	C-733	C-938
C-326A	C-585	C-739	
C-327	C-586	C-739A	

NOTE:
BEFORE STARTING CONSTRUCTION CONTRACTOR MUST CHECK WITH UTILITIES FOR LOCATIONS OF EXISTING STRUCTURES WHETHER OR NOT INDICATED ON PLANS.

PLAN SCALE

LOTS & ALLEYS 1" = 50'

STREET WIDTHS 1" = 50'

4-18" x 12" Y's E. OF MONTE VISTA 12-28-50

DRAINAGE COMPLETED

PAVING COMPLETED

QUANTITIES		ESTIMATED LOTS	ESTIMATED CITY	FINAL LOTS	FINAL CITY
EXCAVATION	CU. YDS.				
NEW CURB	LIN. FT.				
PAVING	SQ. YDS.				
"	"				
"	"				
SIDEWALK	SQ. FT.				
MANHOLES	ADJUST				
	CONSTRUCT				
BASINS	ADJUST				
	CONSTRUCT				
SEWERS-12"	LIN. FT.				

HOR. SCALE	1" = 50'	BOOK	1641	PAGE	49
VER. SCALE	1" = 2'	DATE	LEVELS 6-26-50 DRAWING 8-31-50		
PLAN	G.S.	PROFILE	J.L.	COMPUTED	
CHECKED	J.E.	GRADE	J.E.	CHECKED	

LOTS	2L	859	96	LENGTH	429	98
CITY	2L	36	—	LENGTH	18	—
TOTAL	2L	895	96	LENGTH	447	98
				LOTS	CITY	
COST ADVERTISING						
COST INSPECTION						

DESIGNED BY	
DRAWN BY	G.S.AXON
TRACED BY	
CHECKED BY	Robt. R. Keen
APPROVED	ENGINEER OF STREETS
	DEPUTY CITY ENGINEER

CONTRACT NO. _____

CARD NO. X

RECORD NO.

DEPARTMENT OF PUBLIC WORKS DETROIT

CITY ENGINEER'S OFFICE --- DIVISION OF PAVING DESIGN

STREET PAVING PLAN

INDEX NO.	TOPO NO.
61	89

ASSIGN. NO. 378-C-6

PETITION NO. _____

NAME OF STREET MARGARETA

FROM E.P.L. MANOR

TO W.P.L. PINEHURST

SHEET 1 OF 1 SHEETS

TYPE OF PAVEMENT ~~8-6-8~~ ORE COURSE CONCRETE INTEGRAL CURB ~~8" UNIFORM AT STREET INTERSECTIONS EXCEPT AS NOTED~~

DRAINAGE

WIDTH 30' & 26'

CONTRACT APPROVED C.C. _____ TO _____

Weber Request 6-19-60

Started in at 4 Basin E. of Monte Vista on 12-27-50

BENCH MARKS — ELEVATION

P.B.M. #89-251 N.E. CORNER CURTIS & MEYERS — 183.710

ARROW FIRE HYD. S.E. CORNER MARGARETA & MANOR — 192.67

ARROW FIRE HYD. S.W. CORNER MARGARETA & MONTE VISTA — 194.02

ARROW FIRE HYD. S.W. CORNER MARGARETA & PINEHURST — 194.01

P.B.M. # 89-251A N.E. CORNER MONTE VISTA & CURTIS. — 186.782
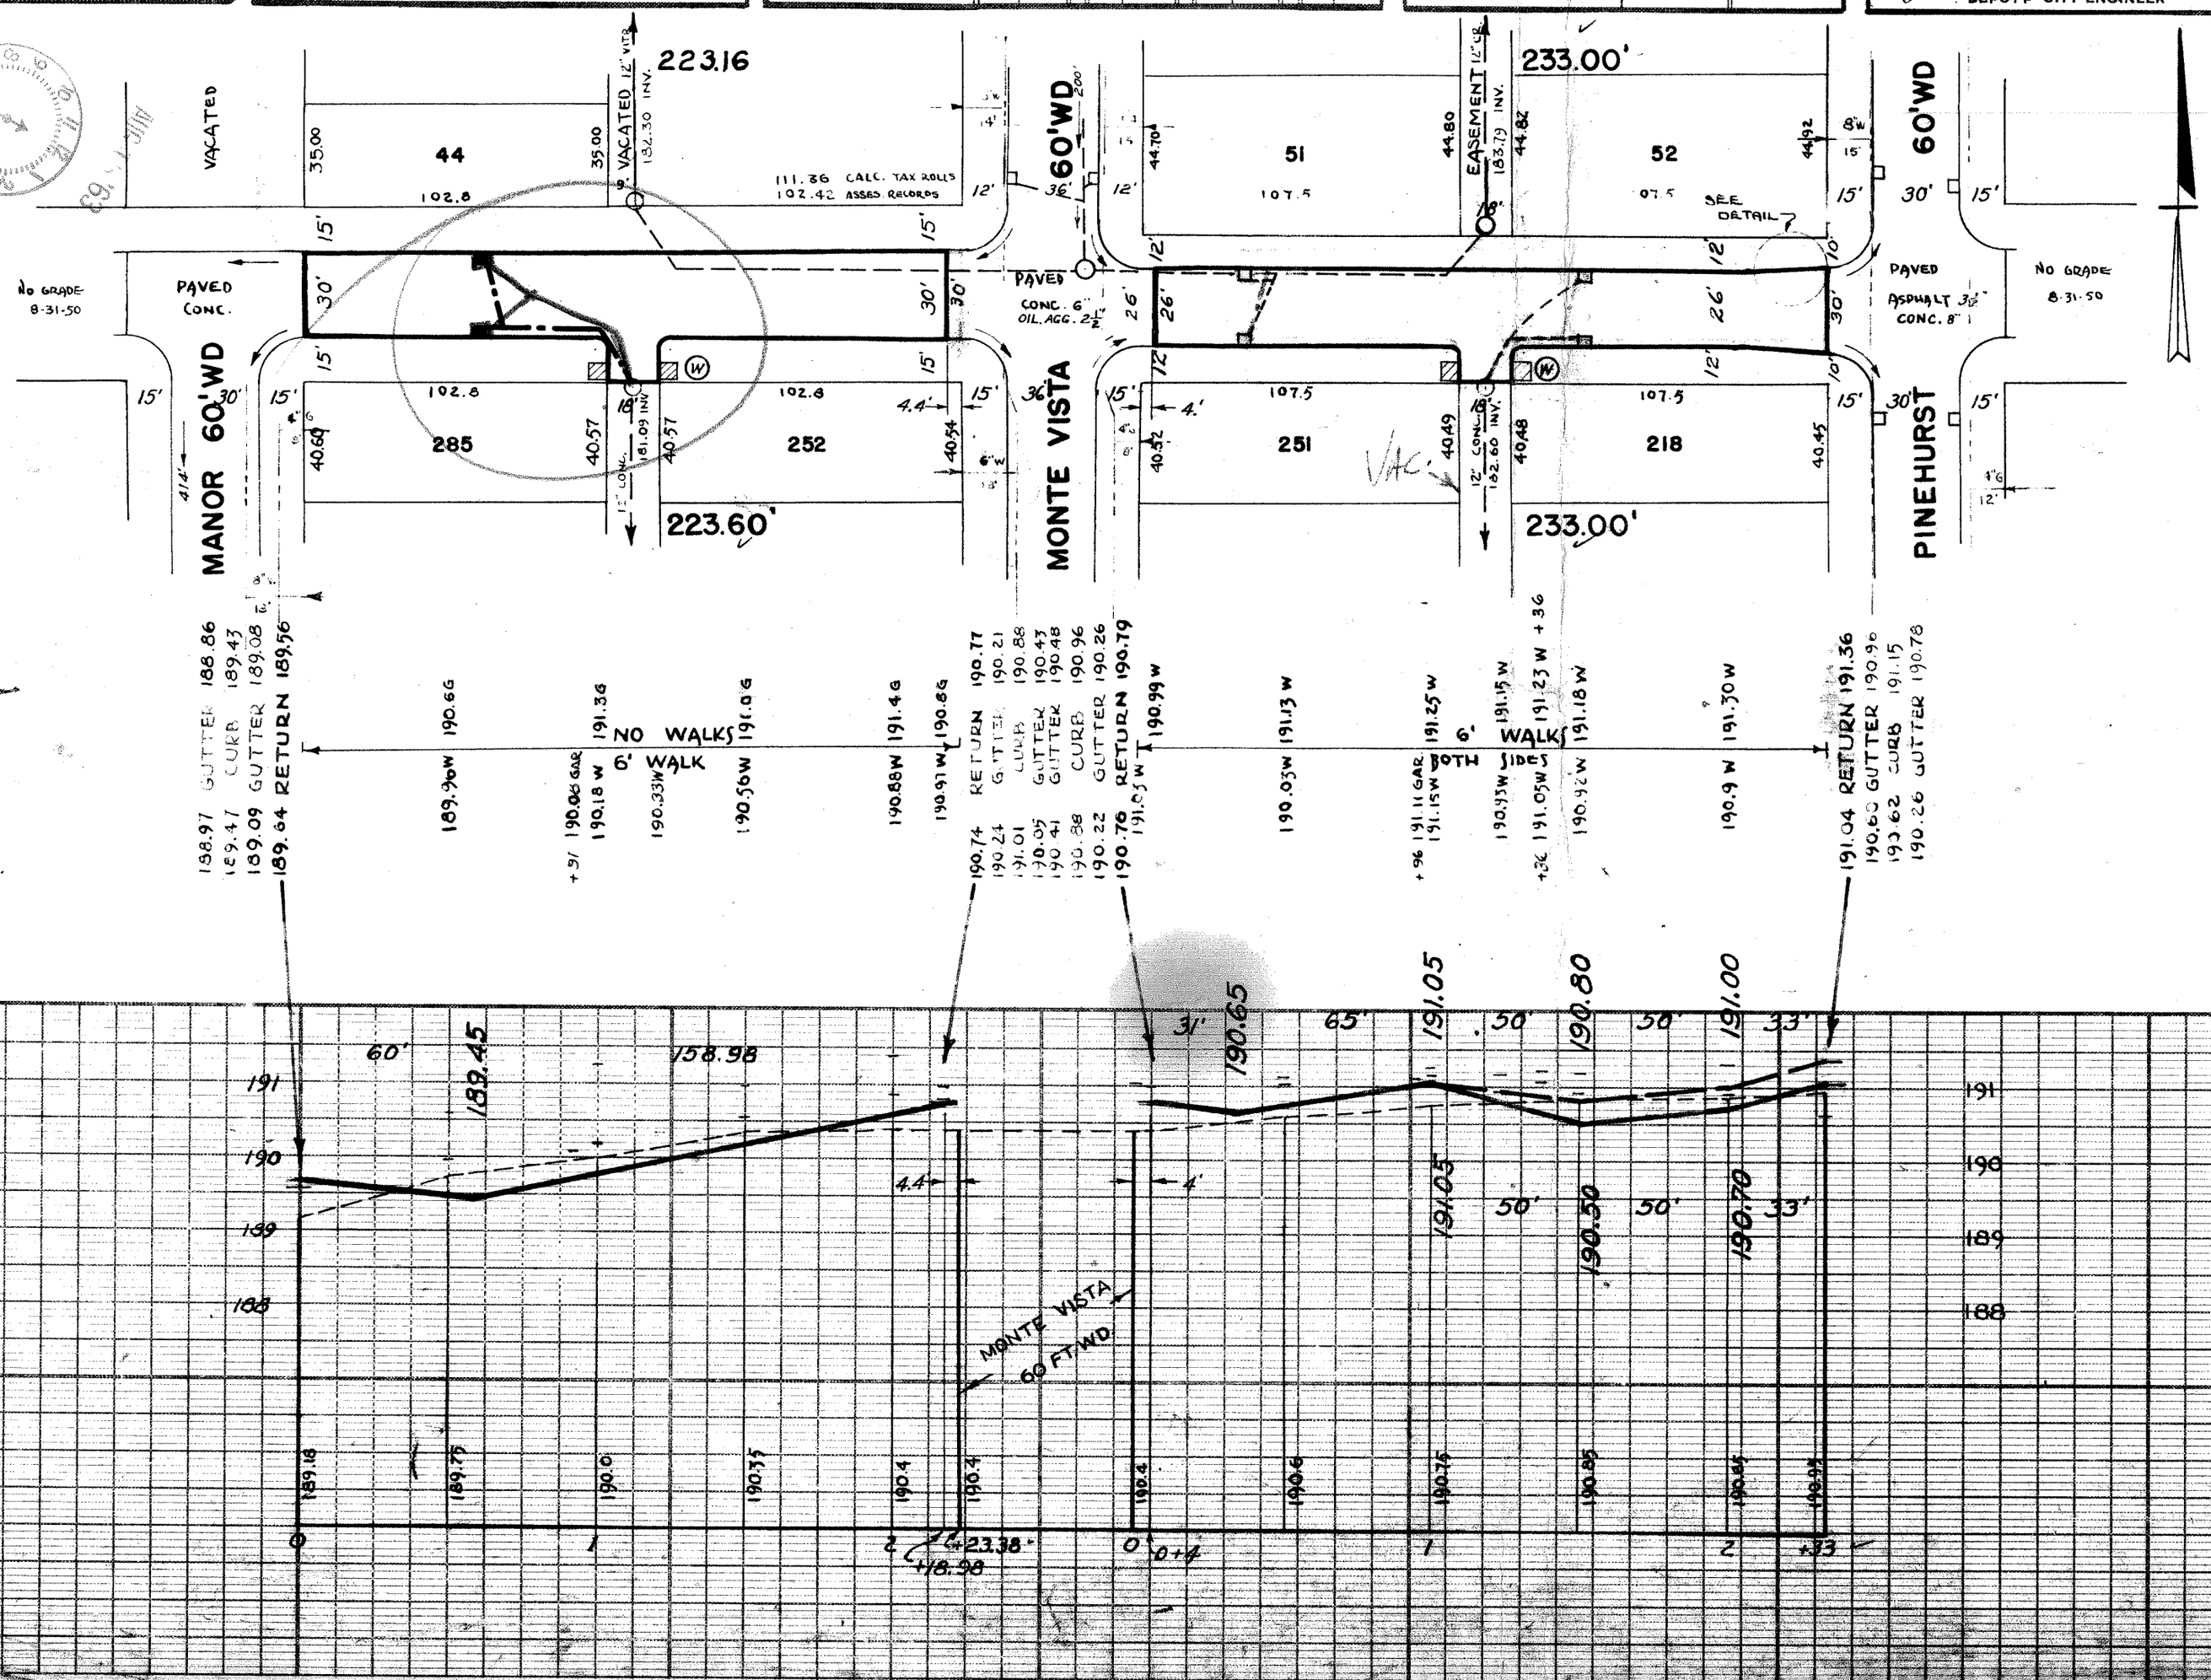
NOTE: P.L. OFFSET 5' TO + IN WALK