Sewer, Cr. N

T. Water Bd 9-26-38

CIRCLES						
AT	NO	Δ	RADIUS	TANG.	ARC	SEG.

QUANTITIES	LOTS	CITY	LOTS	CITY
EXCAVATION				
STRAIGHT CURB NEW				
OLD CURB RESET				
CIRCULAR CURB				
PAVING				
CONCRETE BASE				

HOR. SCALE 1" = 100' BOOK 3043 PAGE 72
VER. SCALE 1" = 4' DATE 8-18-38

PLAN CHECKED	W.E.	PROFILE GRADE	W.E.	COMPUTED CHECKED	9/23/40
LOTS 2L	10	730	13	LENGTH	5 36 50 ft
CITY 2L		520		WIDTH	260
TOTAL 2L	11	250	13	WIDTH	2 62 50 ft
				LOTS	CITY
COST ADVERTISING BLANKS					
COST INSPECTION					

CARD NO ○

INDEX NO	TOPO NO
61	88

RECORD NO ○

DEPARTMENT OF PUBLIC WORKS DETROIT

CITY ENGINEER'S OFFICE --- DIVISION OF PAVING DESIGN

STREET PAVING PLAN

NUMBER OF SHEETS 4

SHEET NO 4

NAME OF STREET NORFOLK 50' WD.

FROM WL LIVERNOIS

TO EL MENDOTA

TYPE OF PAVEMENT _____ WIDTH _____

Inspected 1-5-39

DESIGNED BY	V. Guillematy	APPROVED
DRAWN BY	W. Enlow	W. Wallace ENGINEER OF STREETS
TRACED BY		Mabel R. Foster ASST. CITY ENGINEER in Charge
CHECKED BY	V. Guillematy	

▭ EXISTING POOLS & BASINS
■ NEW " " "

BENCH MARKS

ARO. HYD. N.E COR. WYOMING – NORFOLK ——— 191.85
ARO. HYD. N.E. COR. WASHBURN – NORFOLK ——— 190.19
ARO. HYD. N.E. COR. GRIGGS – NORFOLK ——— 187.72

GRADE REVISED 9-22-38 V.G.

WATER MAINS OK 10-19-38
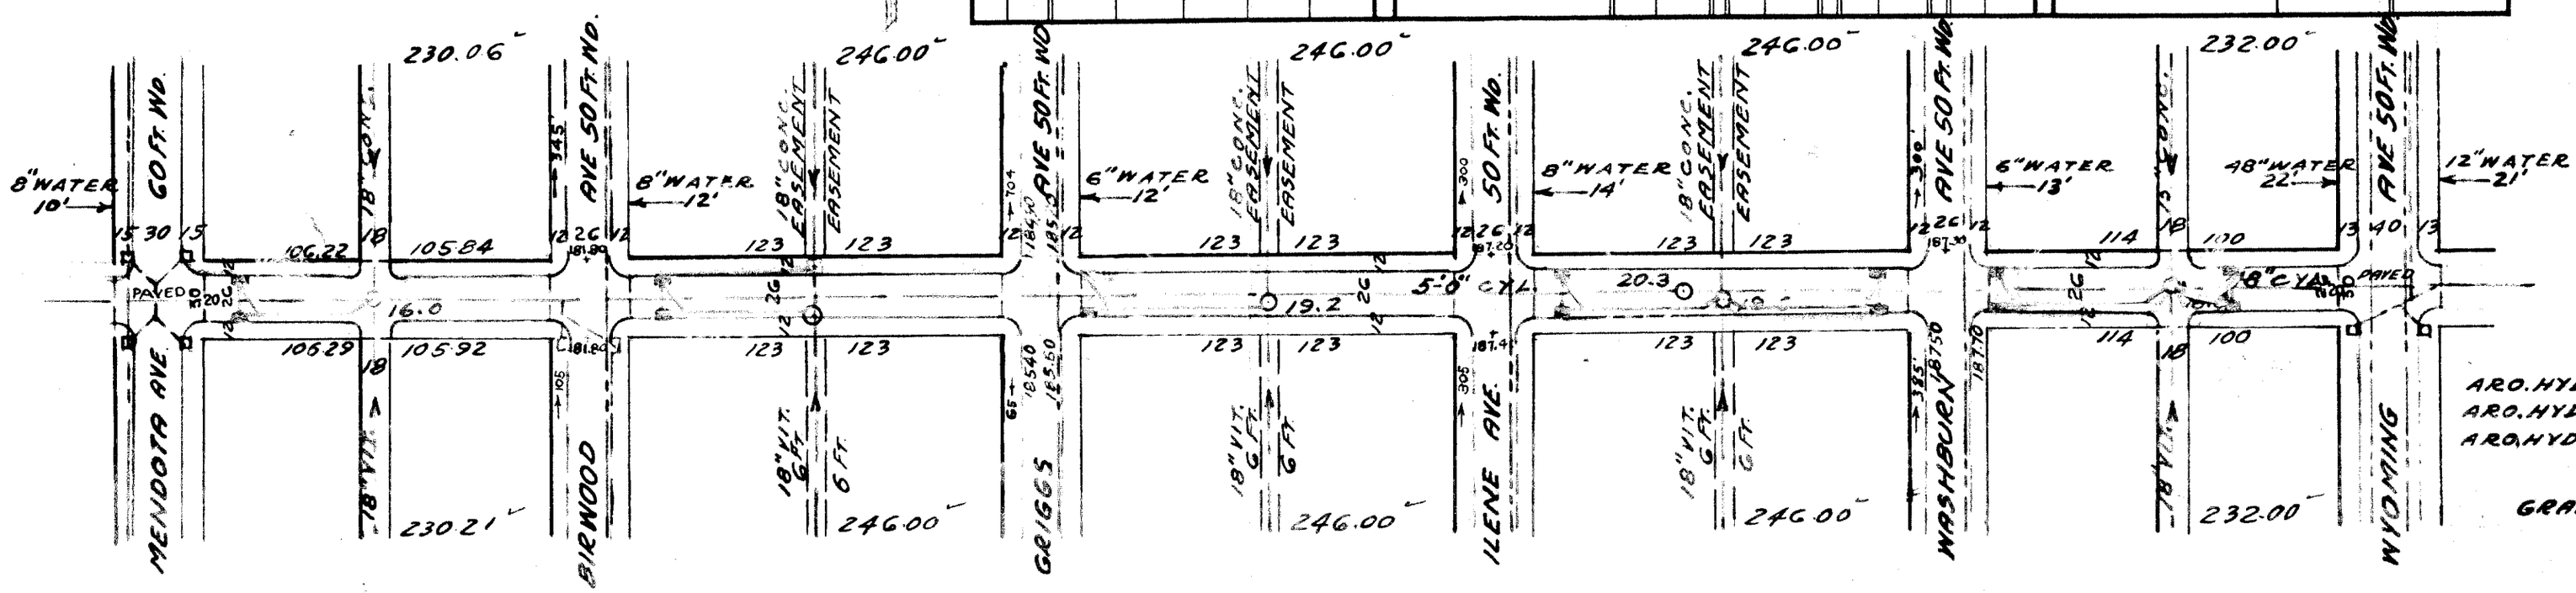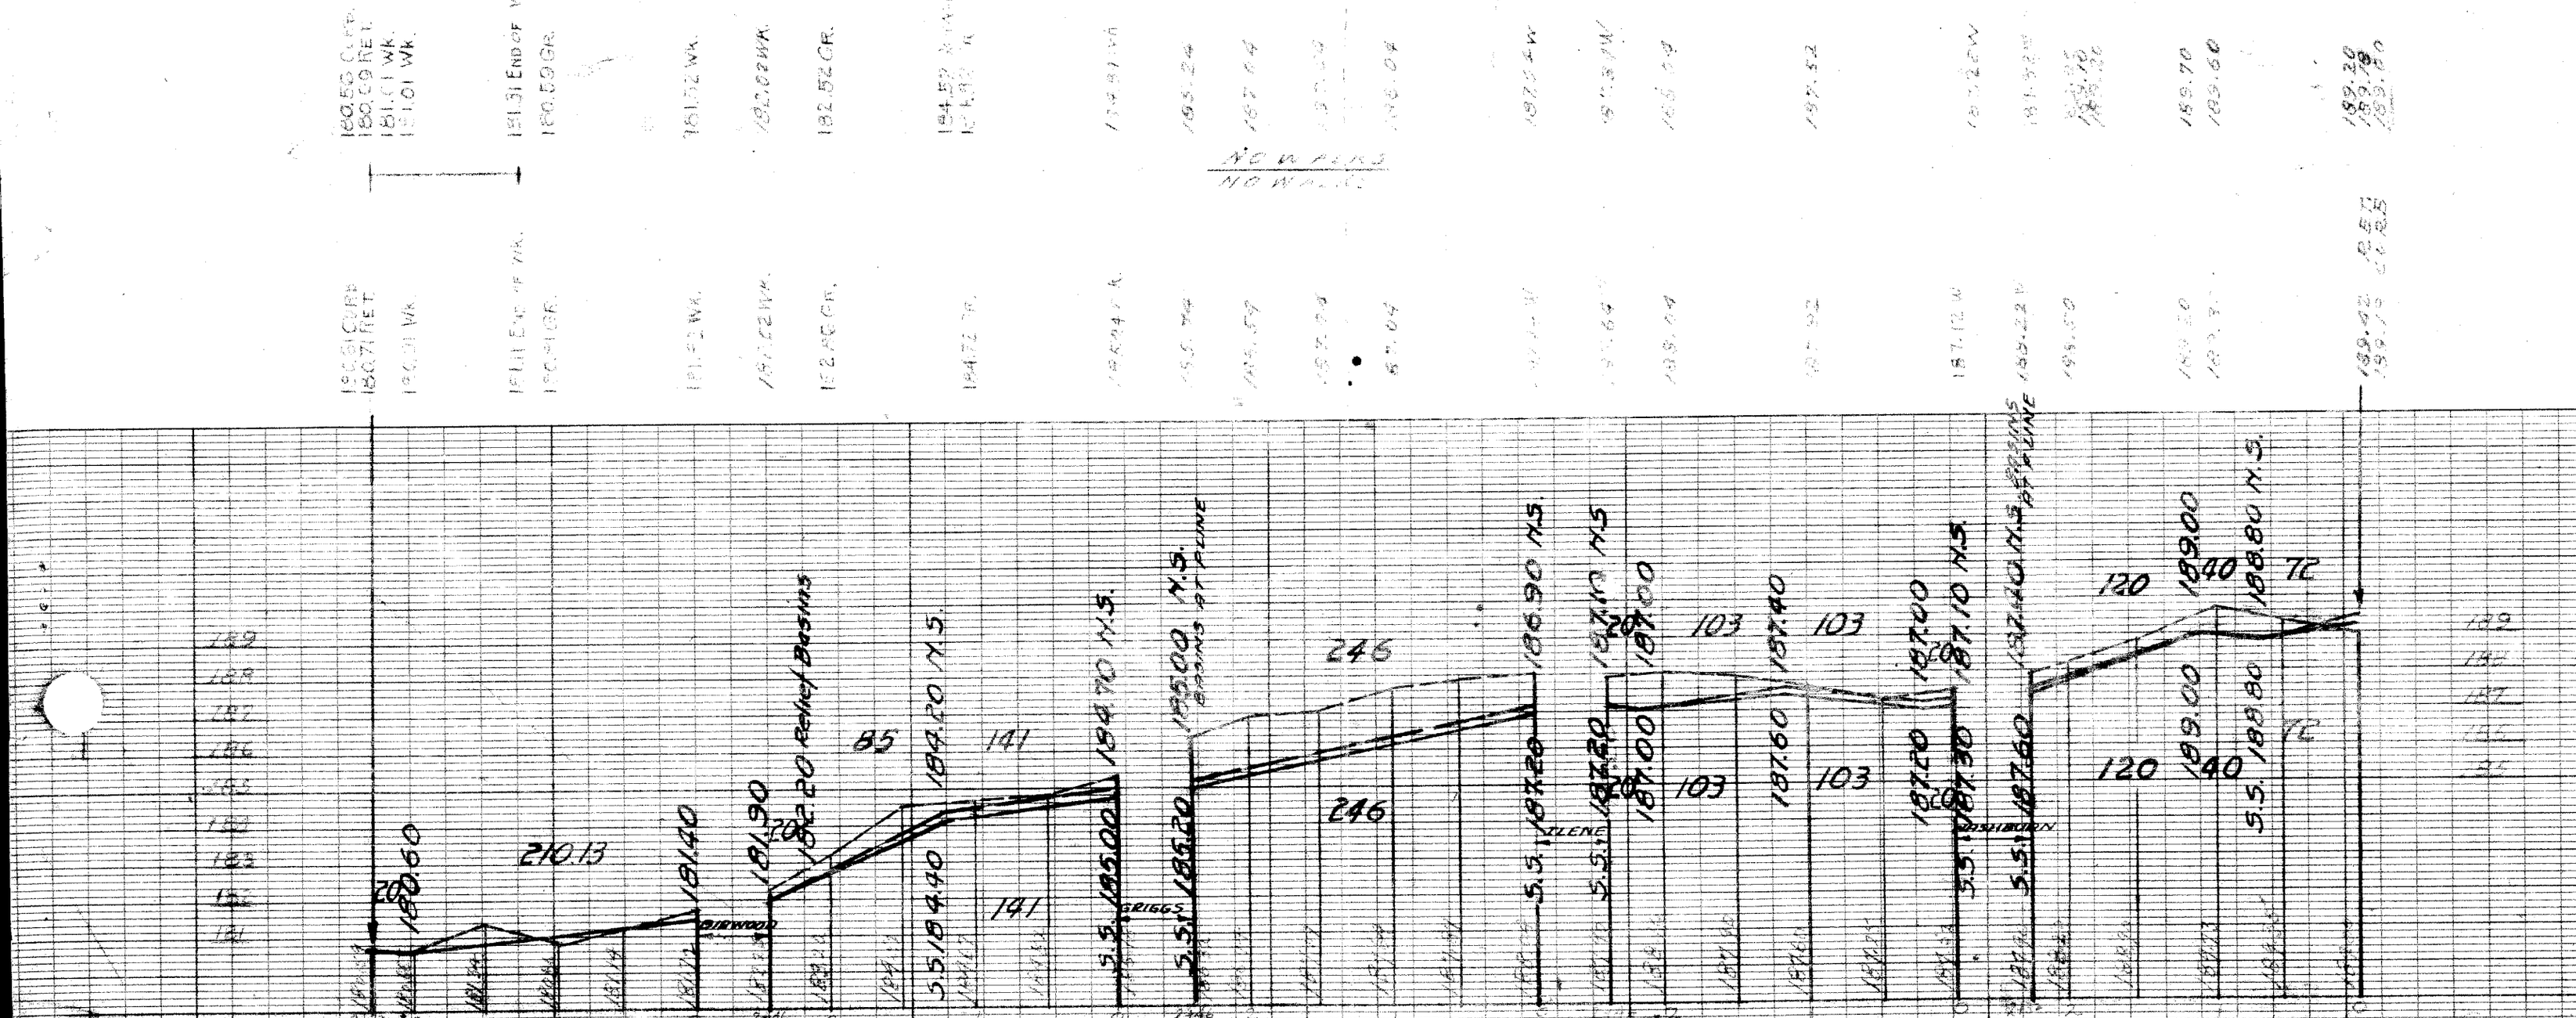
JOB NO D-2063