2BP 3-744

1-B-4-44
3-18-44

| SEWER | JOB NO. | PROGRESS | | QUANTITIES | LOTS | CITY | LOTS | CITY |
|---|---|---|---|---|---|---|---|---|
| INDEXED | BLUE PRINT ISSUED FOR: | DATE | START FINISH | EXCAVATION | 1711 | 144 | | |
| REVISIONS: | GRADE ONLY | | | STRAIGHT CURB NEW | 1810 | 68 | | |
| | CATCH BASINS | | | OLD CURB RESET | | | | |
| | PAVING-CLASS- | | | CIRCULAR CURB | 0 | 60 | | |
| | | | | PAVING | 3620 | 316 | | |
| | DEPT. OF WATER SUPPLY | | | SEWERS 12" L. FT. | 365 | 30 | | |
| | GAS CO. | | | M.H. ADJ ST | | | | |
| | | | | C.B. CONSTR. | 7 | 1 | | |
| | | | | WALKS - SQ. FT. | — | 72 | | |

| | | | |
|---|---|---|---|
| HOR. SCALE 1" = 100' Sec Stamp | BOOK 1537 PAGE 18 | DESIGNED BY | |
| VER. SCALE 1" = 2' | DATE 1-20-1944 | DRAWN BY | F. Sanello |
| PLAN CHECKED GS | PROFILE GRADE P.D' R³ COMPUTED CHECKED PD' R³ | TRACED BY | |
| LOTS 2L 1830.00 LENGTH 915.00 | | CHECKED BY | GS R³ |
| CITY 2L 66.00 LENGTH 33.00 | | APPROVED | S. L. Barton |
| TOTAL 2L 1896.00 LENGTH 948.00 | | | W. Wallace |
| | LOTS CITY | | ENGINEER OF STREETS |
| COST ADVERTISING BLANKS | | | Martin R. Fisher |
| COST INSPECTION | | | ASSISTANT CITY ENGINEER |

CARD NO. 64 87 (INDEX NO. / TOPO. NO.)

RECORD NO.

# DEPARTMENT OF PUBLIC WORKS DETROIT

CITY ENGINEER'S OFFICE --- DIVISION OF PAVING DESIGN

"B" A.P.-3-9

## STREET PAVING PLAN

NUMBER OF SHEETS 1 — SHEET NO 1

NAME OF STREET PEMBROKE

FROM 33 FT. W. OF E. P.L. OF SCHAEFER

TO W. P.L. OF CHEYENNE AVE.

TYPE OF PAVEMENT 10:8:10 (8") ONE COURSE CONCRETE. WIDTH 36'

| BENCH MARKS | ELEV. |
|---|---|
| TOP OF HYD. N.E. COR. PEMBROKE & HARTWELL | 184.205 |
| BRASS CAP IN HAND HOLE NE. COR. PEMBROKE & SNOWDEN | 180.817 |
| TOP OF HYD N.E. COR. PEMBROKE & LITTLEFIELD | 185.084 |
| TOP OF HYD N.E. COR. PEMBROKE & CHEYENNE | 184.892 |

NOTE:
AT Ⓢ CONSTRUCT RETURNS WITH 10' WIDENING. SEE SPECIAL DETAIL SHEET C-371. CONCRETE SLAB IN SCHAEFER RD. TO BE 10" THICK
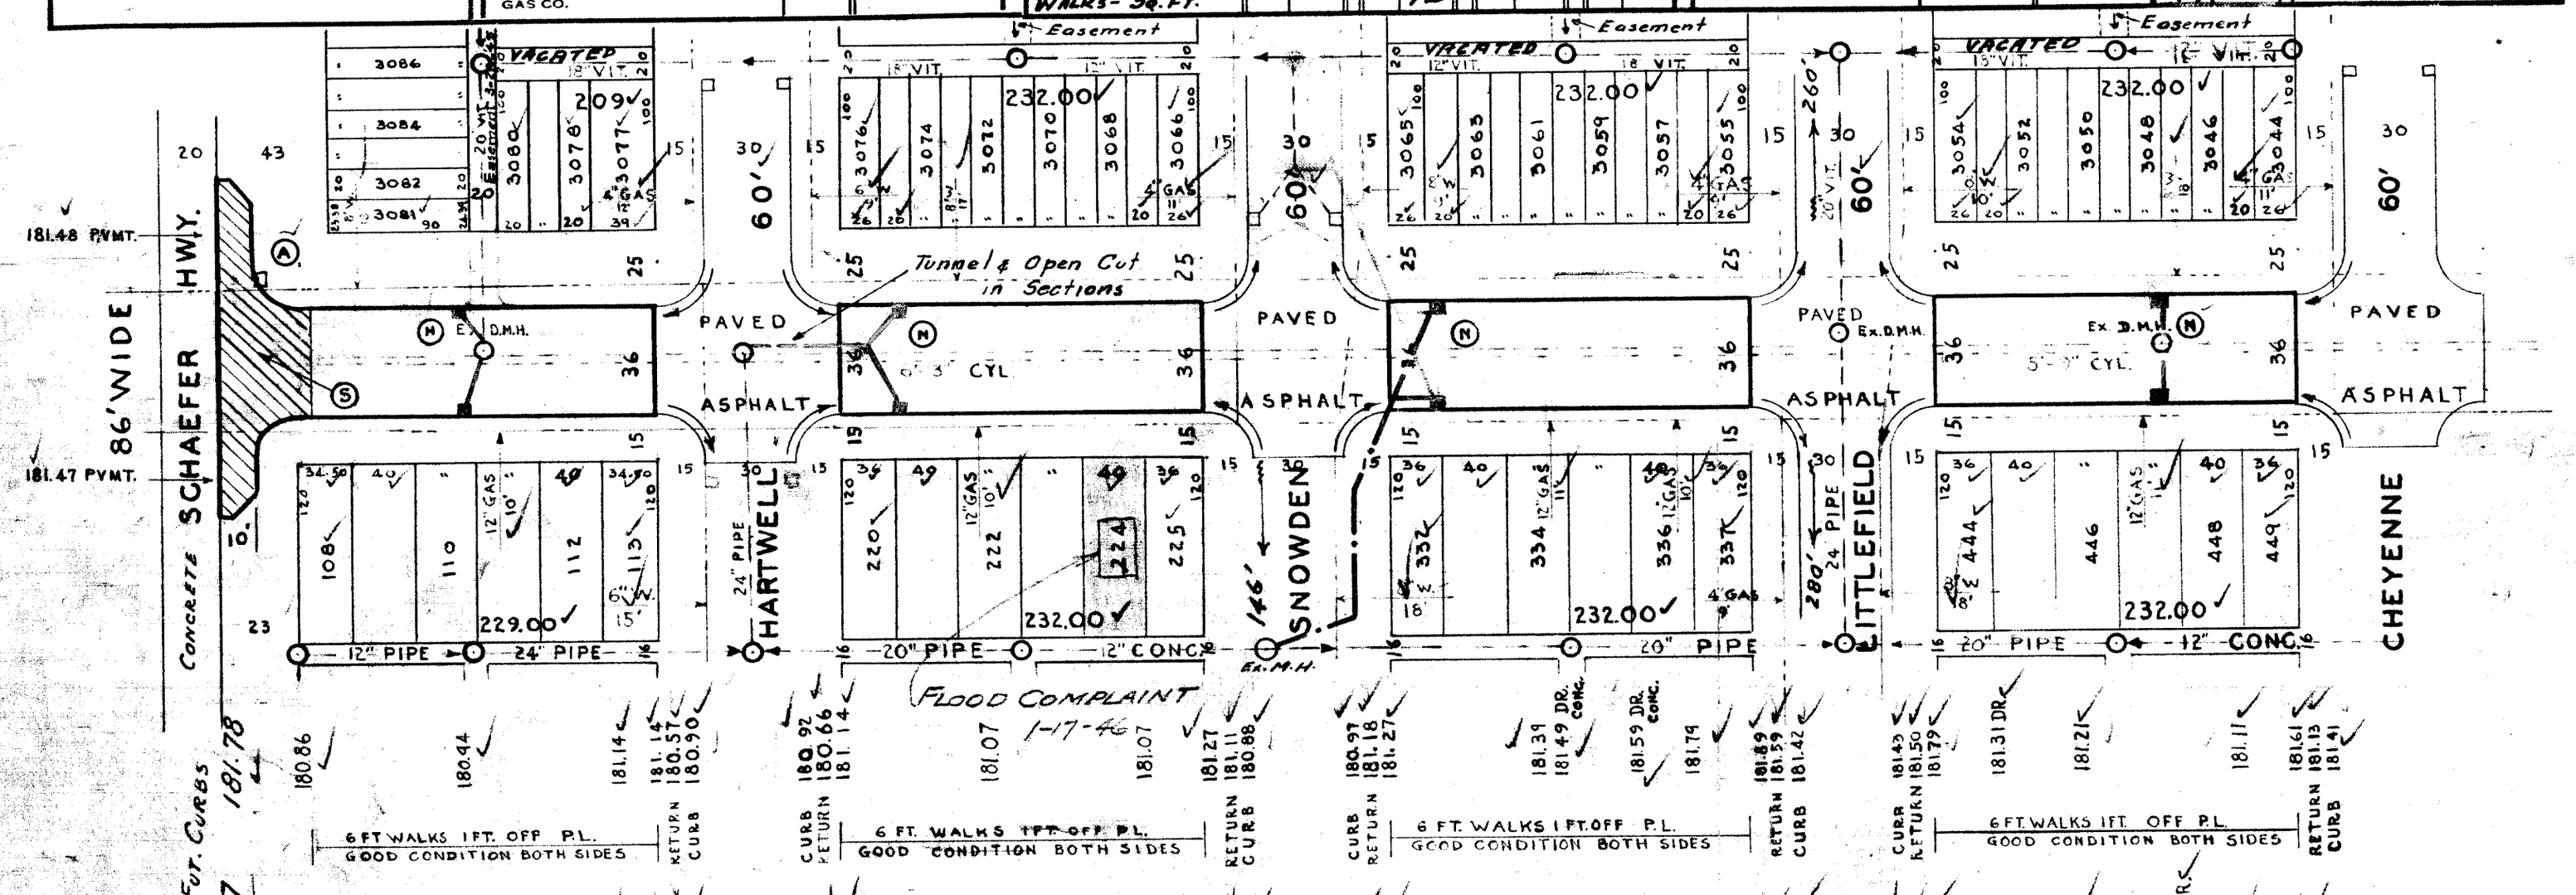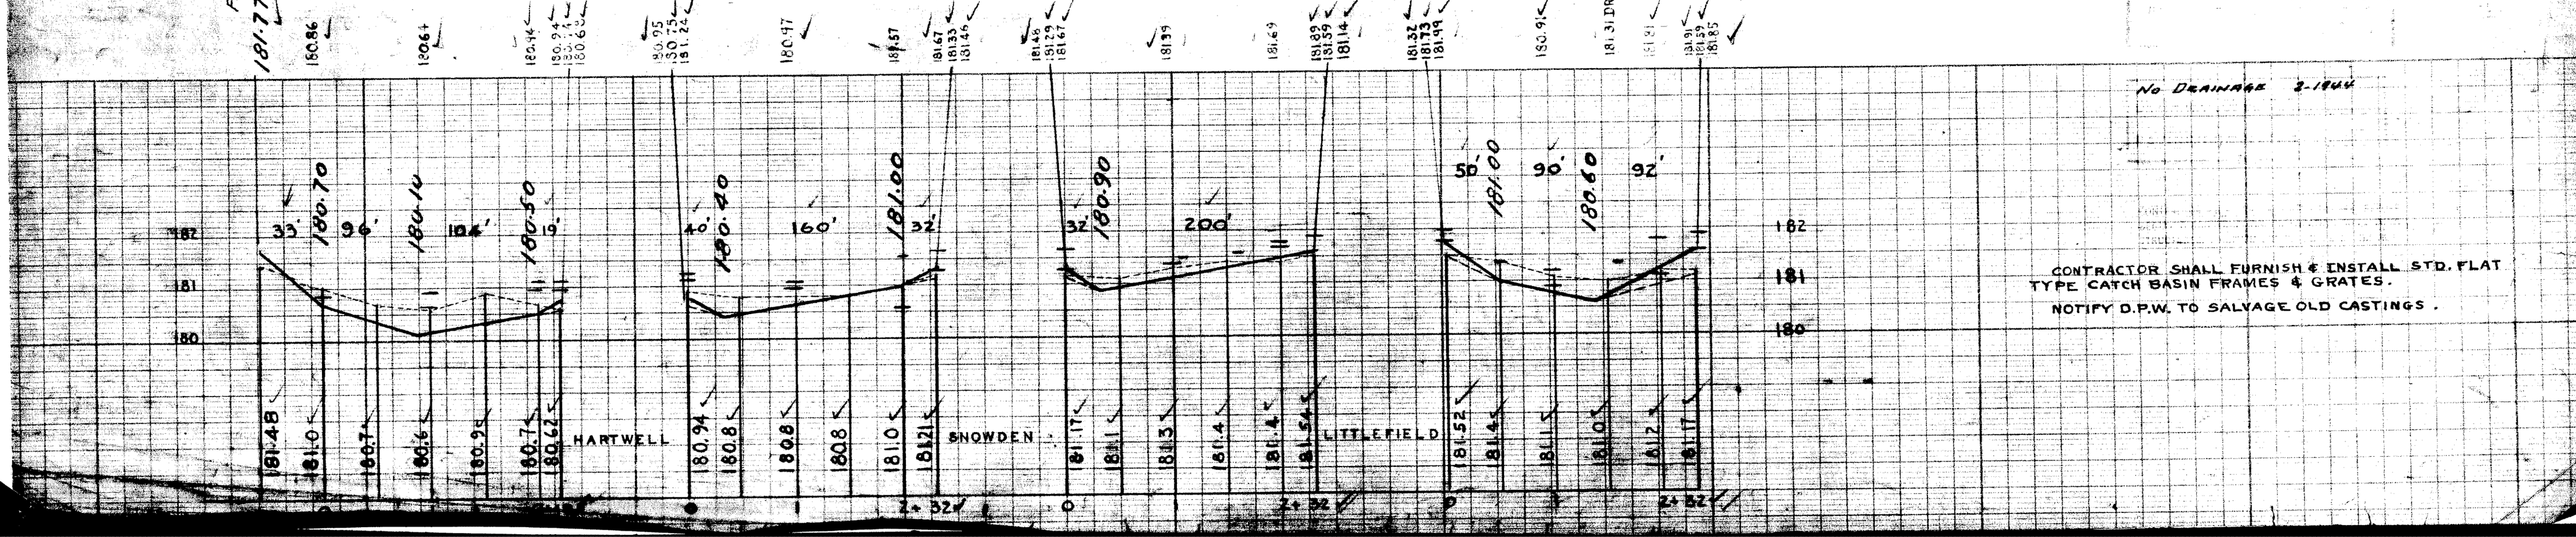
AT Ⓐ ABANDON ONE EXISTING 12" L. BASIN
AT Ⓜ CONSTRUCT 8 ST'D 18"X12" Y BASINS COMPLETE AND CONNECT TO EXISTING OUTLETS AS SHOWN.