ETP 4-22-6

10/30/47

SEWER	OK 3/18/44
INDEXED	
REVISIONS:	Changed Grade at Stansbury 10/30/47 S.A.S.

JOB NO.		PROGRESS	
BLUE PRINT ISSUED FOR:	DATE	START	FINISH
GRADE ONLY			
CATCH BASINS			
PAVING-CLASS-			
DEPT. OF WATER SUPPLY			
GAS CO.			

QUANTITIES	LOTS	CITY	LOTS	CITY
EXCAVATION	1087 ✓	409 ✓		
STRAIGHT CURB NEW	1380 ✓	153 ✓		
OLD CURB RESET				
CIRCULAR CURB	–	222 ✓		
PAVING	2380 ✓	911 ✓		
CONCRETE BASE				
WKS.-SQ.FT.	–	432 ✓		
C.B.s-CONST.	6 ✓	–		
12" SEWER LIN.FT.	170	60		

HOR. SCALE	1" = 100' / 1" = 50'		BOOK 1534	PAGE 37	
VER. SCALE	1" = 2'		DATE F.B.-PLAN-	11-43 / 1-44	
PLAN CHECKED	R.E.R. S.S.	PROFILE GRADE	R.E.R. R³	COMPUTED CHECKED	R.E.R. S.S.

LOTS 2L	1428 20 ✓	LENGTH	714 10 ✓		
CITY 2L	279 74 ✓	LENGTH	139 87 ✓		
TOTAL 2L	1707 94 ✓	LENGTH	853 97 ✓		
			LOTS	CITY	
COST ADVERTISING BLANKS					
COST INSPECTION					

DESIGNED BY	
DRAWN BY	
TRACED BY	Robert E. Reid.
CHECKED BY	GS R³

APPROVED J. L. Baston
ENGINEER OF STREETS
Martin R. Fisher
ASS'ST. CITY ENGINEER

CARD NO.

INDEX NO.	TOPO. NO.
64	86

RECORD NO.

DEPARTMENT OF PUBLIC WORKS DETROIT

CITY ENGINEER'S OFFICE --- DIVISION OF PAVING DESIGN

STREET PAVING PLAN

H. A.P. 3-24

NUMBER OF SHEETS: 1

SHEET NO.: 1

NAME OF STREET: PICKFORD

FROM: E.P.L. ARDMORE

TO: W.P.L. JAMES COUZENS

TYPE OF PAVEMENT: _____ WIDTH: 30'

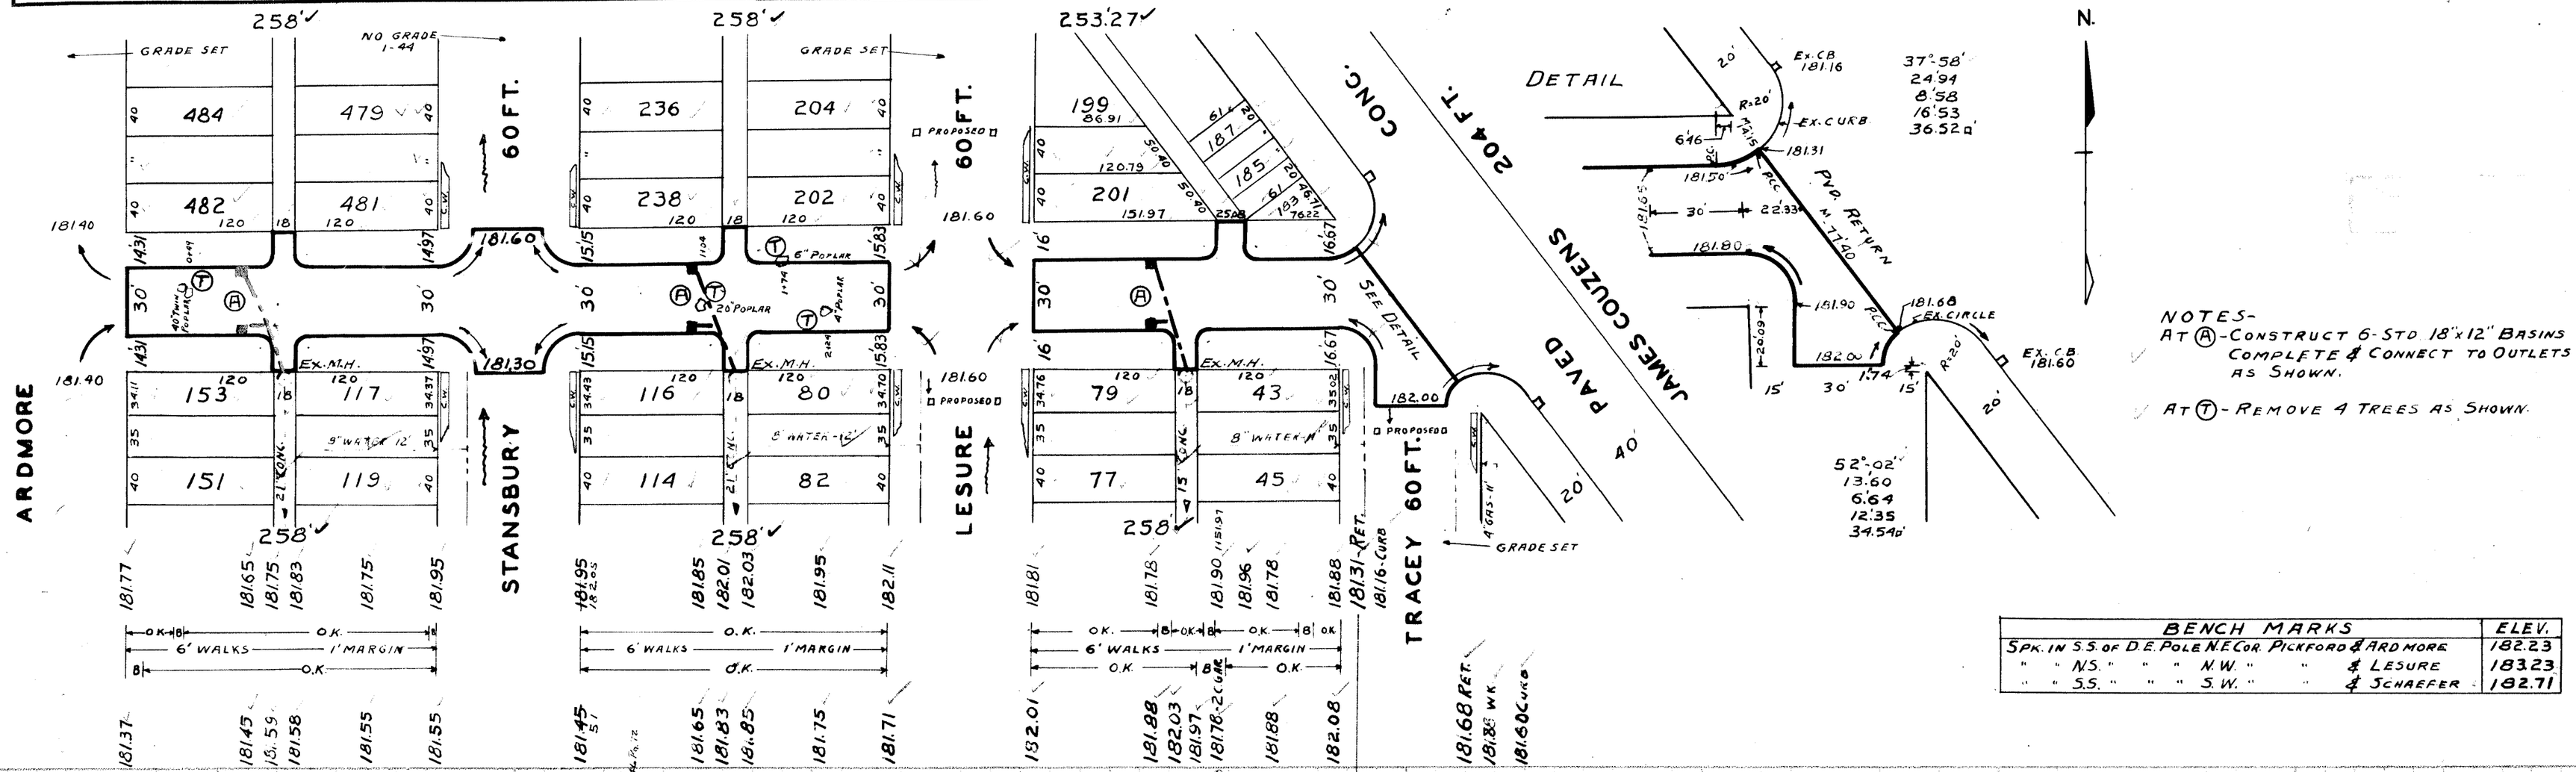

N.

NOTES-
AT Ⓐ - CONSTRUCT 6-STD. 18"x12" BASINS COMPLETE & CONNECT TO OUTLETS AS SHOWN.

AT Ⓣ - REMOVE 4 TREES AS SHOWN.

BENCH MARKS	ELEV.
SPK. IN S.S. OF D.E. POLE N.E. COR. PICKFORD & ARDMORE	182.23
" " N.S. " " " N.W. " " & LESURE	183.23
" " S.S. " " " S.W. " " & SCHAEFER	182.71

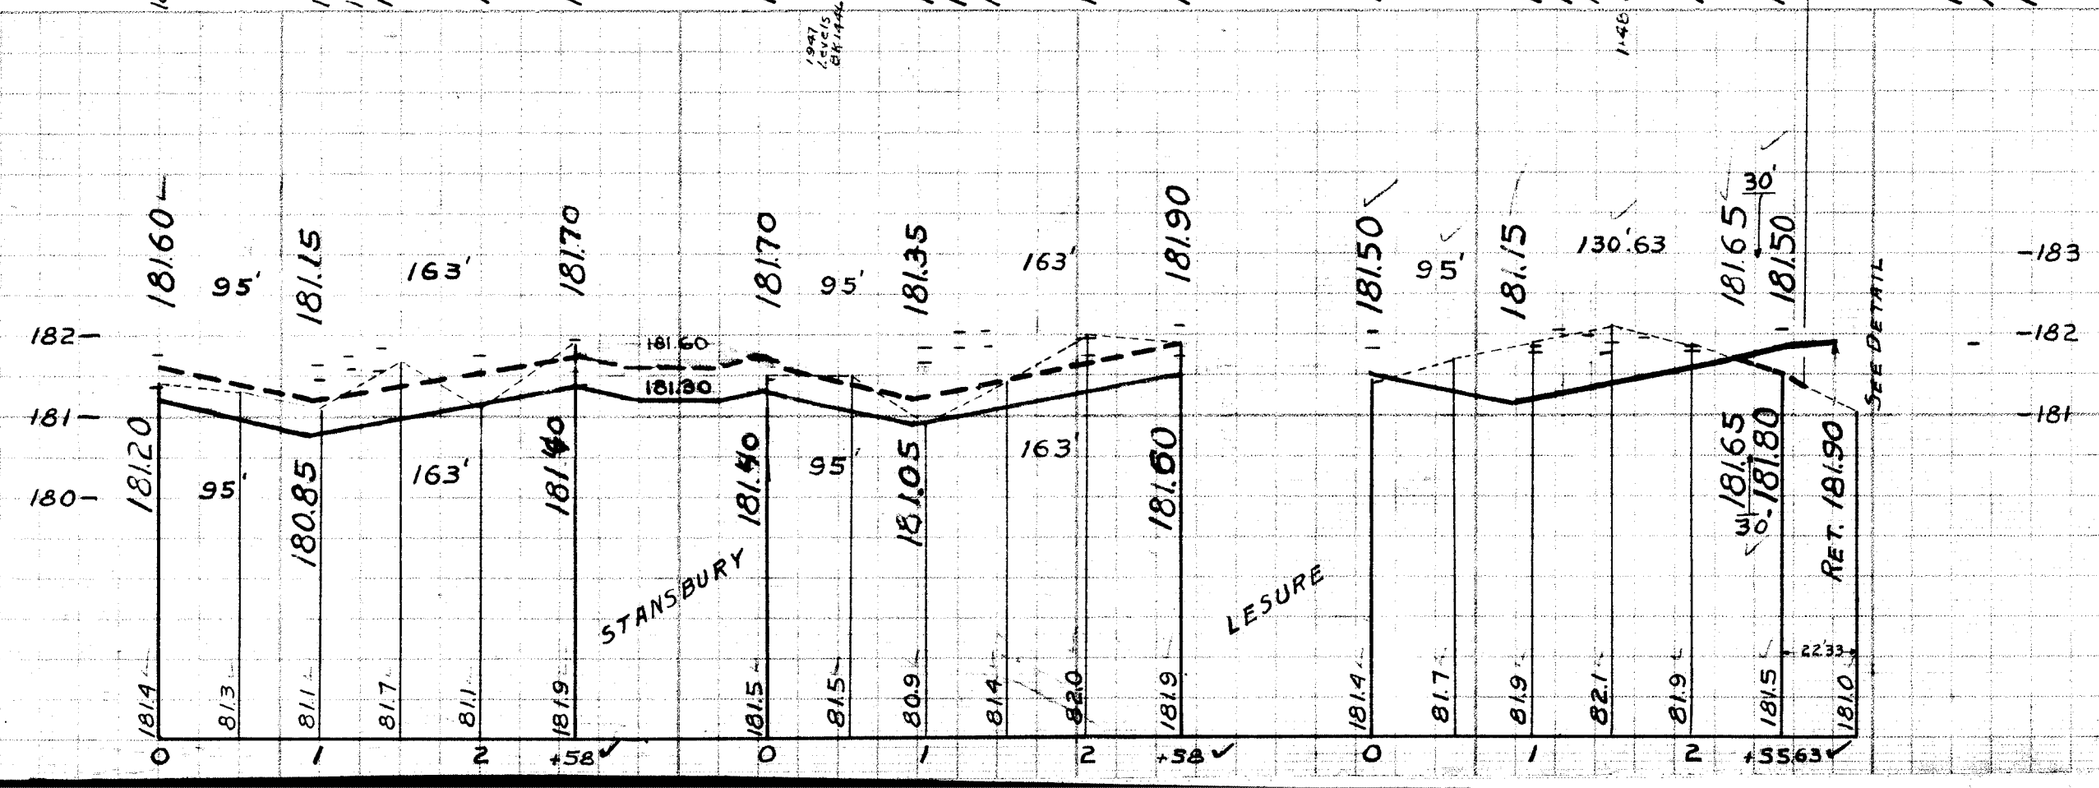

NO ORDINANCE JAN-44