JOB ~~C-11012~~

Bk. pg.	LOTS	CITY
Excavation		
Paving		
Ret. Plank 2" x 8"		
Curb Concrete		
Ret. Stone		
Circles		
INSPECTION		

FINAL		
Bk. 947 pg. 37	LOTS	CITY
Excavation		
Paving		
Ret. Plank 2" x 8"		
Curb Concrete		
Ret. Stone		
Circles		

Lots Length	4	688	40	½	2	344	20
City Length		451	32	½		225	66
Total	5	139	72		2	569	86
FINAL LENGTH							

Designed by	V. Gruttemeyer	Approved
Drawn by	K. Barkhouse	Robt. R. Reon
Traced by	Elmer White	W. J. Wallace, Engineer of Streets
Checked by	V. Gruttemeyer	Martin R. Fisher, ASST City Engineer
Scale: Hor. 1" = 100' Ver. 1" = 2'	Date 6-21-39	

Card No.

DEPARTMENT OF PUBLIC WORKS DETROIT

CITY ENGINEER'S OFFICE --- DIVISION OF PAVING DESIGN

STREET PAVING PLAN

Index No.	Topo No.
63	105

Record No.

NAME OF STREET PREVOST AVE. 60'

FROM ~~7 MILE~~ S.L. VASSAR

TO PEMBROKE

CLASS "B" - 8" MAC. + 2½" OIL AGG. 30' WIDE

S-Y

NUMBER OF SHEETS 2

SHEET NO. 2

EXISTING POOLS & BASINS

NEW " " "

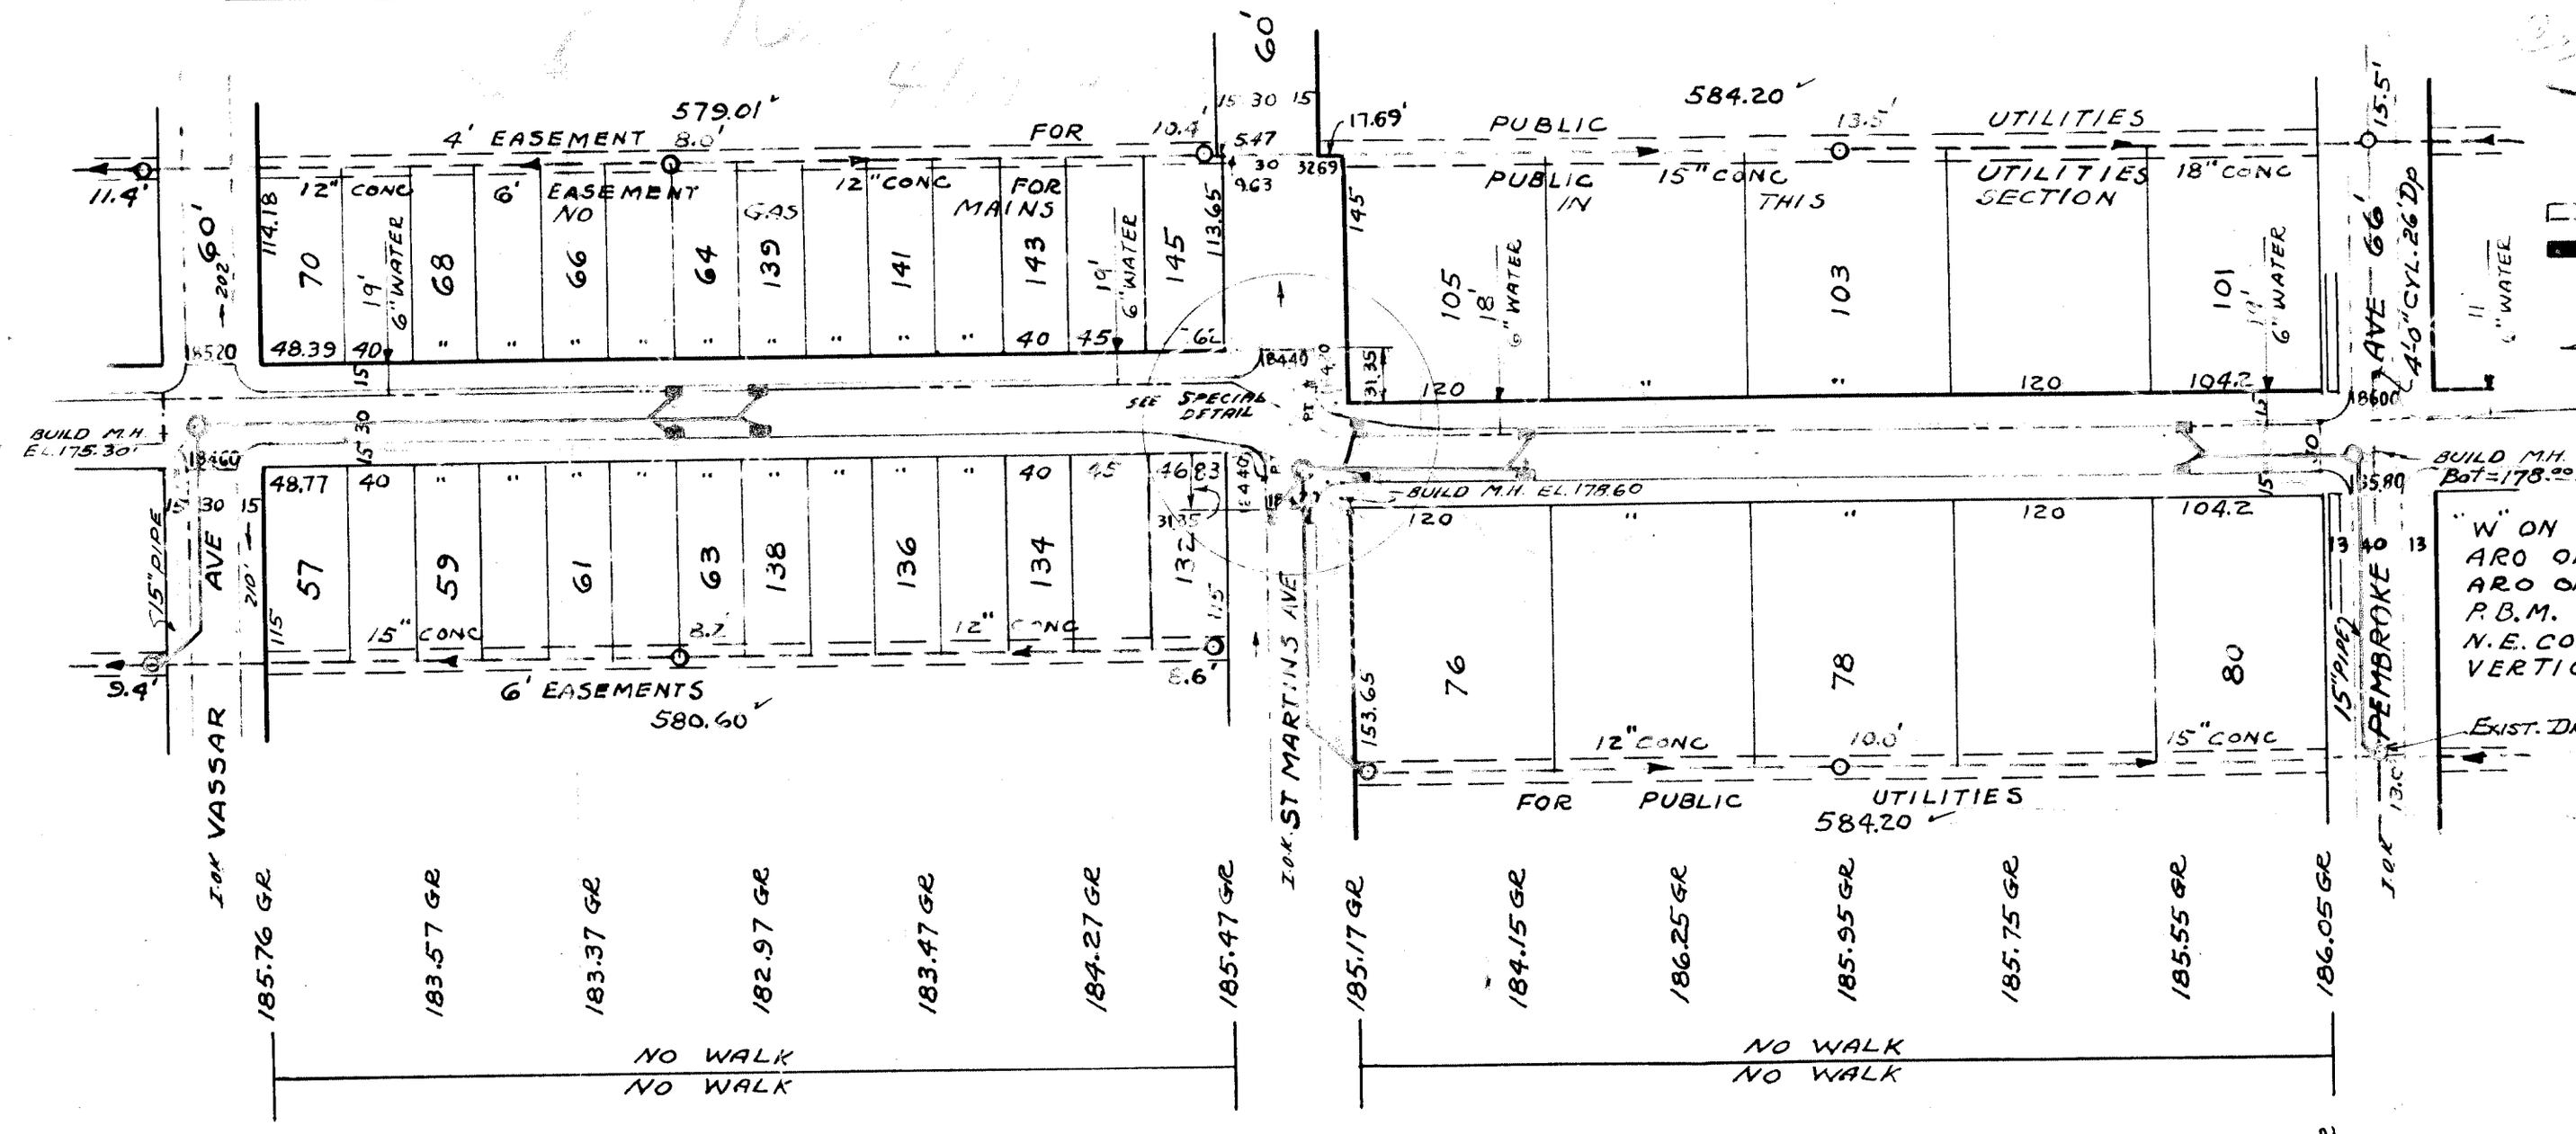

BENCH MARKS

"W" ON W B GATE N.W. COR. PREVOST & VASSAR 184.57

ARO ON HYD N.W. COR. PREVOST & ST MARTINS 187.88

ARO ON HYD S.W. COR. PEMBROKE & PREVOST 189.18

P.B.M. 105311 ASBURY PARK & PEMBROKE. ON THE N.E. COR. OF ASBURY PARK & PEMBROKE IS A VERTICAL TRK SPK IN THE N.S. OF A 20" OAK TREE. 194.626

WATER MAINS OK 8-7-38

S.L. VASSAR TO S.L. PEMBROKE

LOTS	"	2	328	01	½ "	1	164 00
CITY	"		273	32	½ "		136 66
TOTAL	"	2	601	33	"	1	300 66
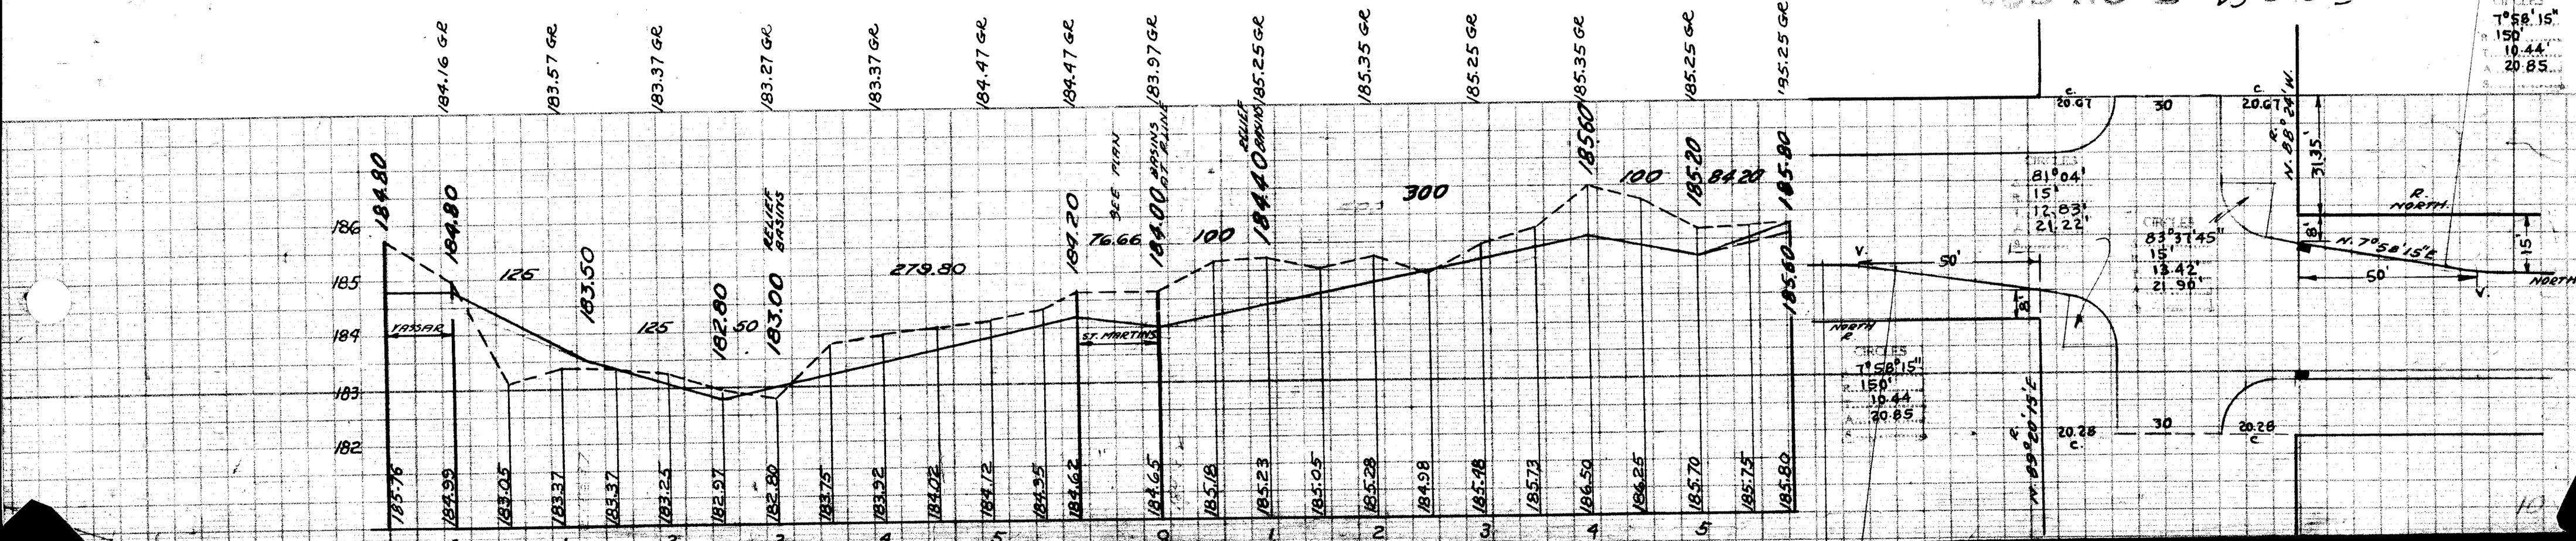
JOB-NO-D-2099