SEWER	OK J. Liegak 1/15/55
REVISIONS	

SUPPLEMENTARY DETAILS			
C-324A	C-390	C-587	C-739B
C-325	C-524	C-733	C-938
C-326A	C-585	C-739	C-1608
C-327	C-586	C-739A	C-1783

NOTE:
BEFORE STARTING CONSTRUCTION CONTRACTOR MUST CHECK WITH UTILITIES FOR LOCATIONS OF EXISTING STRUCTURES WHETHER OR NOT INDICATED ON PLANS.

PLAN SCALE DISTORTED
LOTS & ALLEYS 1" = 100'
STREET WIDTHS 1" = 50'

BY D.P.W.
DRAINAGE COMPLETED 9-20-57

PAVING COMPLETED

QUANTITIES		ESTIMATED LOTS	ESTIMATED CITY	FINAL LOTS	FINAL CITY
EXCAVATION	CU. YDS.				
NEW CURB	LIN. FT.				
PAVING	SQ. YDS.				
"	"				
"	"				
SIDEWALK	SQ. FT.				
MANHOLES	ADJUST				
	CONSTRUCT				
BASINS	ADJUST				
	CONSTRUCT				
SEWERS-12"	LIN. FT.				

HOR. SCALE	1"=100'	BOOK 1855 / 1735	PAGE 8 / 10
VER. SCALE	1" = 2'	DATE LEVELS Sept. 55	DRAWING 11-16-49
PLAN CHECKED	JC / J.E.	PROFILE GRADE	JC / J.E. COMPUTED / CHECKED

LOTS	2L	3	235 39	LENGTH	1617 70
CITY	2L		36 00	LENGTH	18 00
TOTAL	2L	3	271 39	LENGTH	1635 70
					LOTS / CITY
COST ADVERTISING					
COST INSPECTION					

DESIGNED BY	
DRAWN BY	J. Carson
TRACED BY	
CHECKED BY	J.E.
APPROVED	Behm / Wieland / M. Furgason
	ENGINEER OF STREETS / DEPUTY CITY ENGINEER

CONTRACT NO. P.W.

CARD NO. X

DEPARTMENT OF PUBLIC WORKS DETROIT

CITY ENGINEER'S OFFICE --- DIVISION OF PAVING DESIGN

STREET PAVING PLAN

INDEX NO.	TOPO NO.
38	95

ASSIGN. NO. 325-56-6
PETITION NO. 5680

NAME OF STREET REX

RECORD NO.

FROM N.P.L. LIBERAL

TO S.P.L. STATE FAIR

SHEET 1 OF 2 SHEETS

TYPE OF PAVEMENT 8.6.8 ONE COURSE CONCRETE - INTEGRAL CURB — WIDTH 30'

8" UNIFORM AT STREET INTERSECTIONS EXCEPT AS NOTED

CONTRACT APPROVED - C.C. ____ TO ____

PET. # 5680 5-31-55

WEBER REQUEST

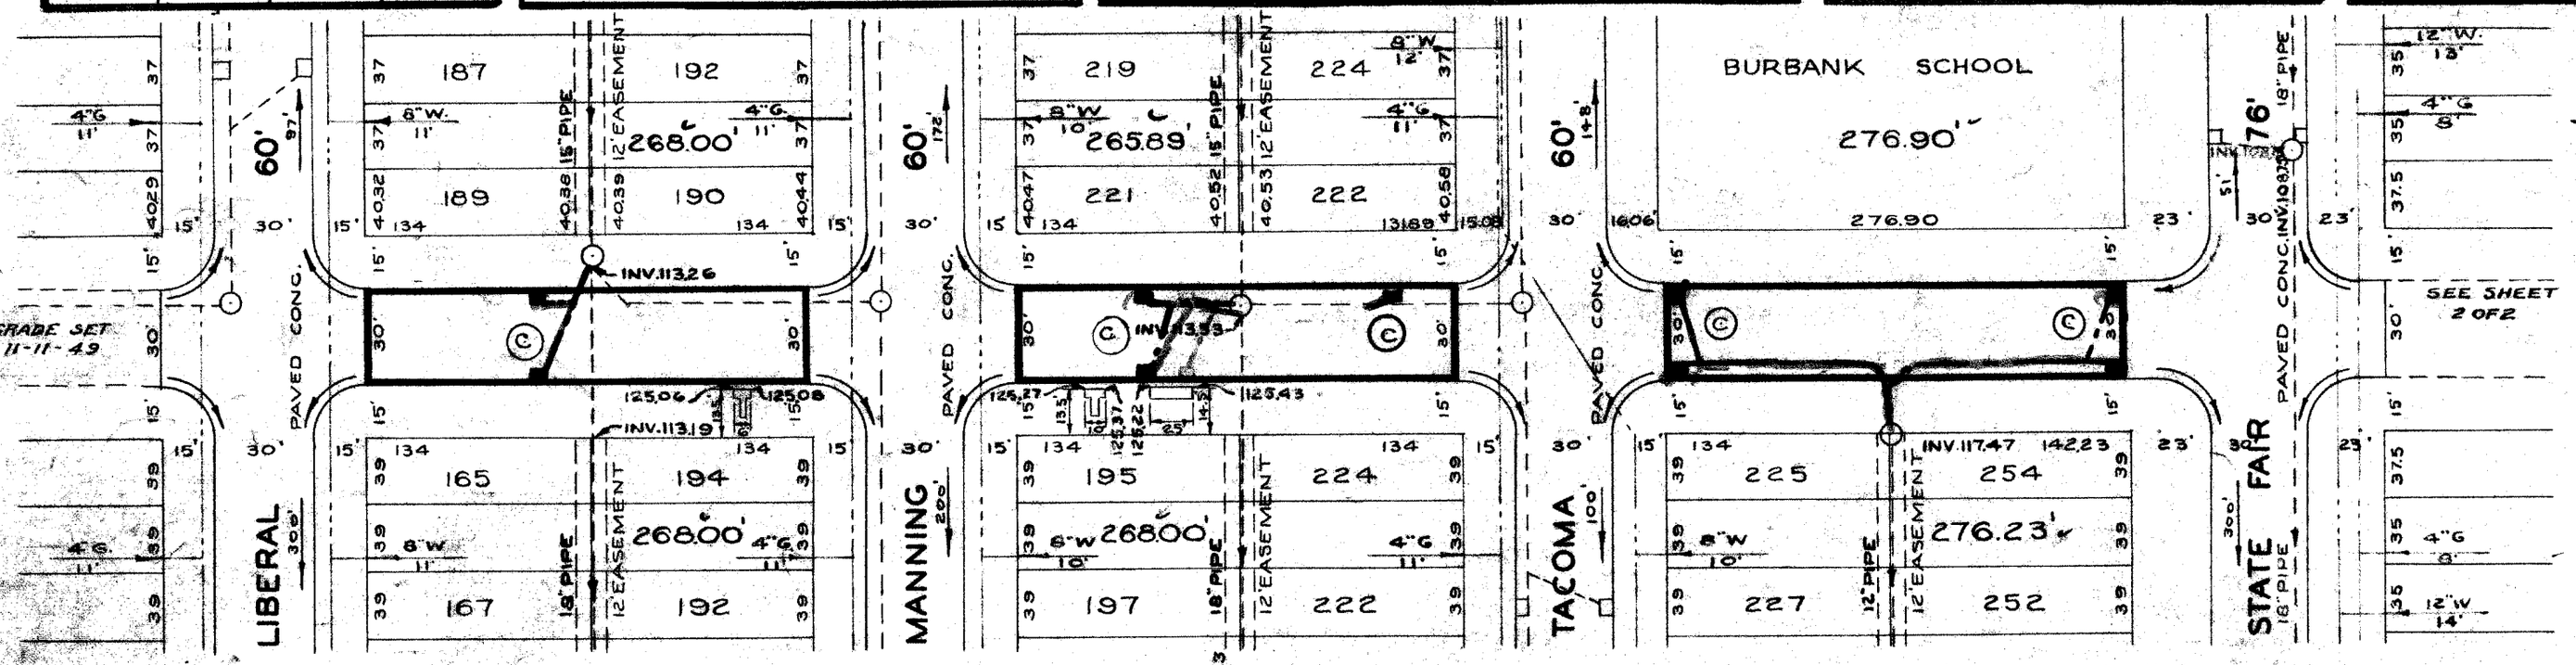

BENCH MARKS

	ELEV.
ARROW TOP OF HYD. N.W. COR. REX & LIBERAL.	127.37
ARROW TOP OF HYD. S.W. COR. REX & TACOMA.	128.36
P.L.B.M. 95-854 N.E. COR. REDMOND & STATE FAIR	123.701

NOTES;
FOR SYMBOLS (A) ETC. SEE STD DETAIL DRAWG #C-327
+ IN WALK 5' OFF E. PROPERTY LINE

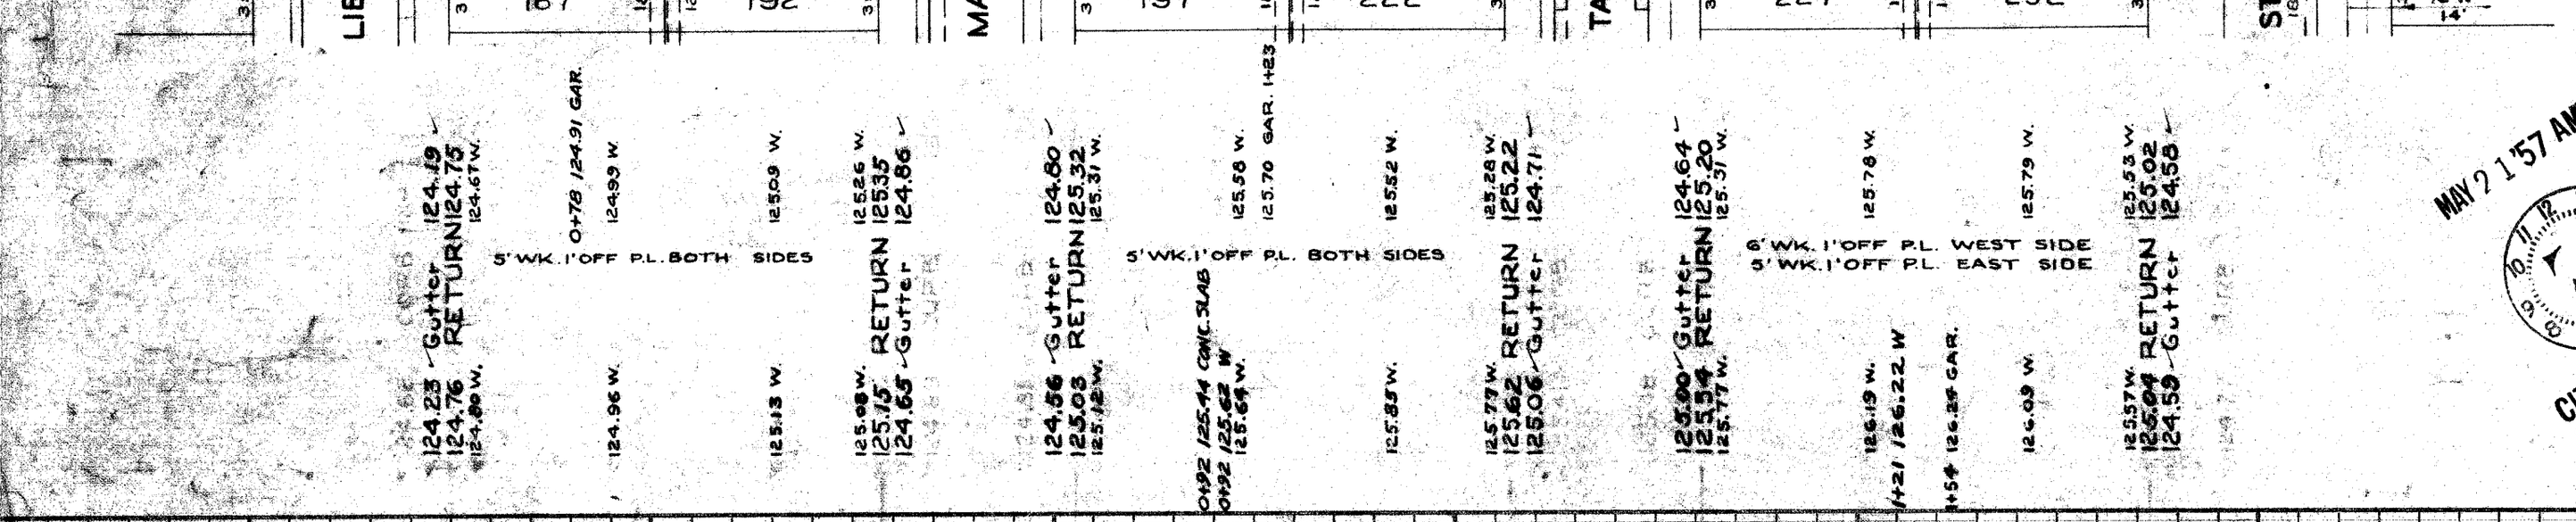

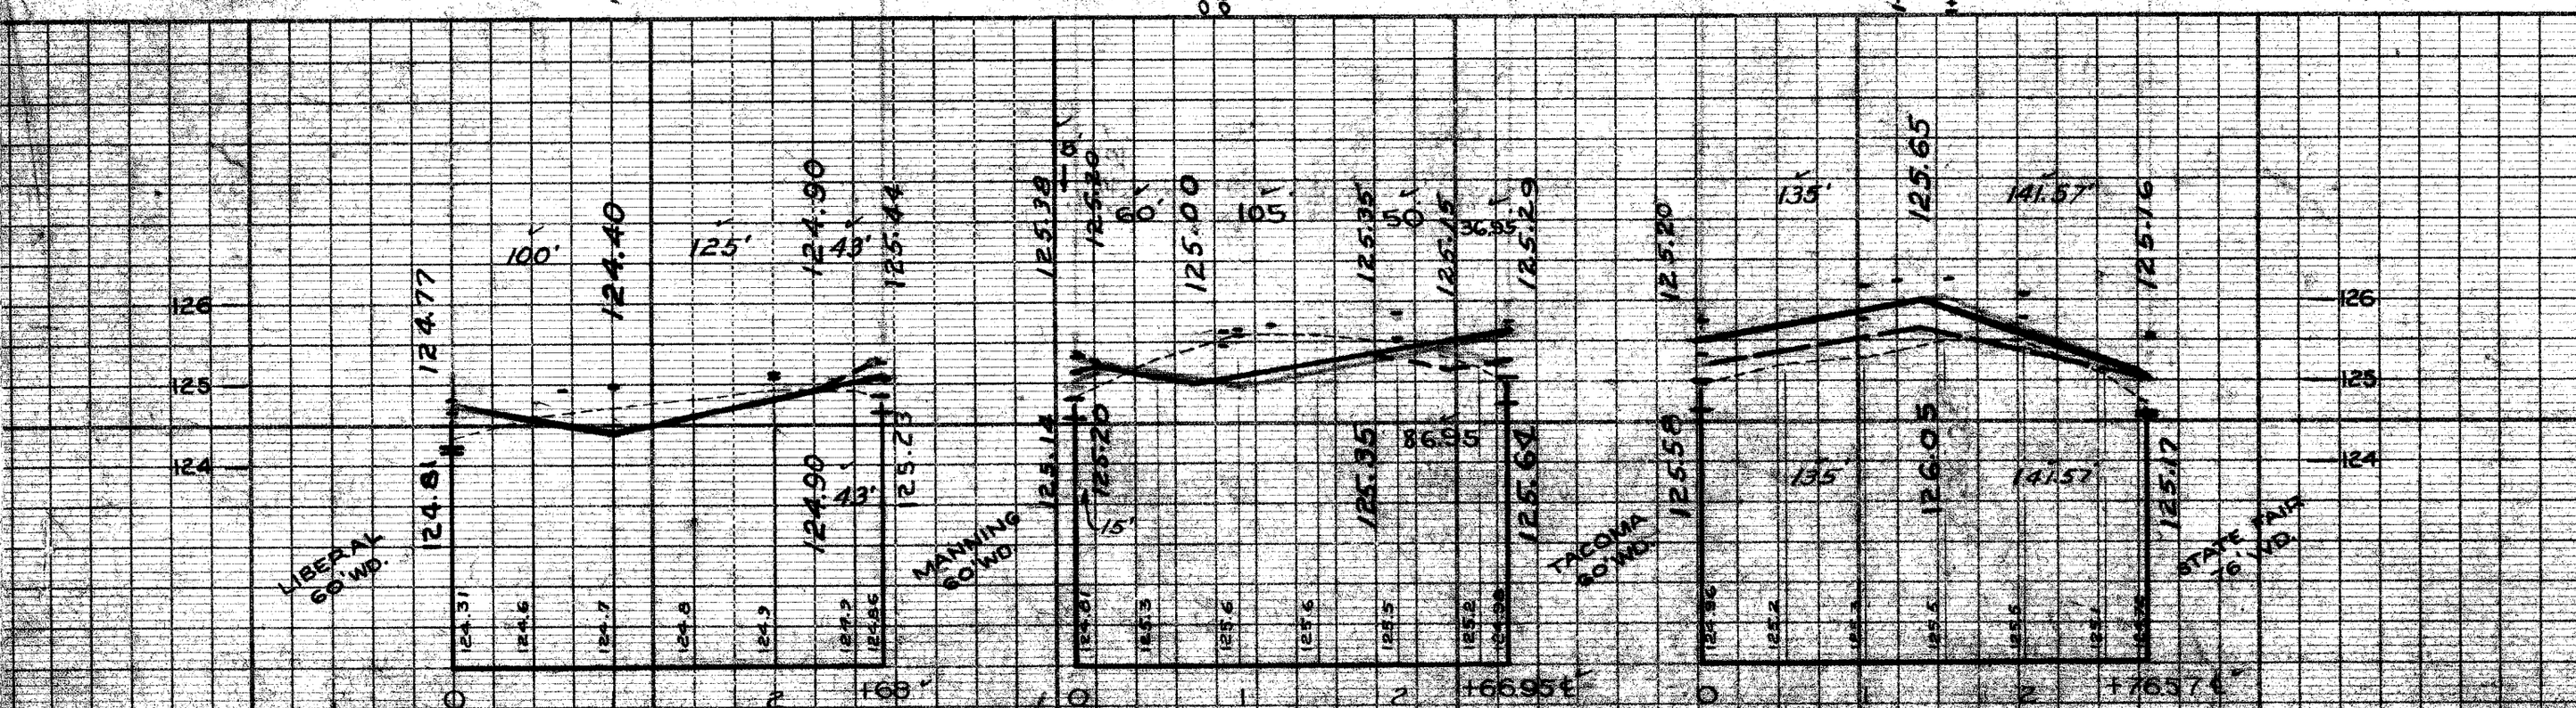

MAY 21 '57 AM
CITY OF DETROIT
SEWER DIVISION

Tracing Posted
O.K. 11-8-57