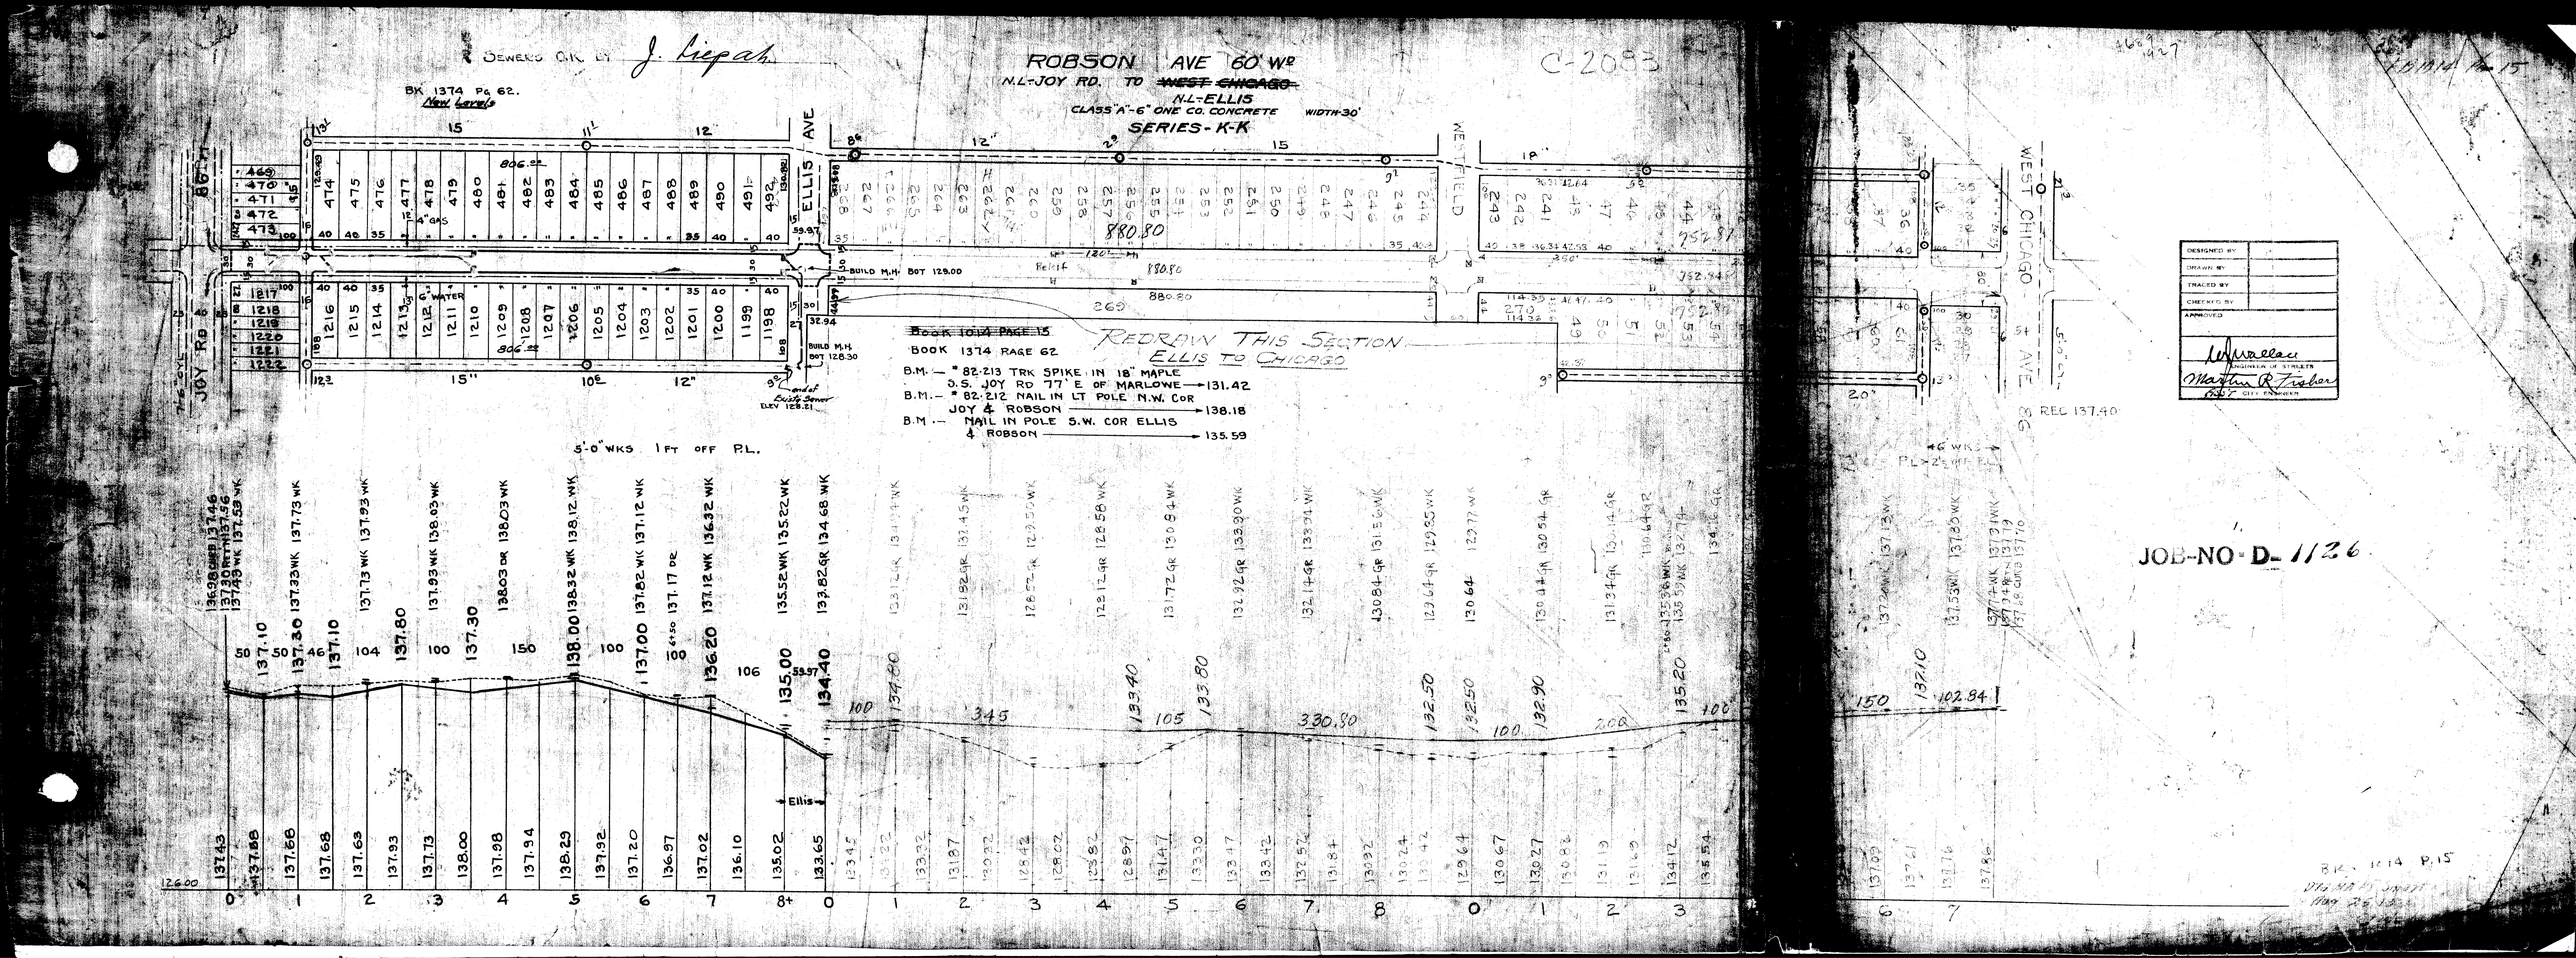

SEWERS O.K. BY J. Liepah
ROBSON AVE 60' WD
N.L.-JOY RD. TO ~~WEST CHICAGO~~
N.L.-ELLIS
CLASS "A"-6" ONE CO. CONCRETE WIDTH-30'
SERIES-K-K
C-2083
BK 1374 Pg 62.
New Levels
ELLIS AVE
WESTFIELD
WEST CHICAGO AVE
JOY RD
BUILD M.H. BOT 129.00
BUILD M.H. BOT 128.30
6" WATER
4" GAS
Relief
~~BOOK 1014 PAGE 15~~
BOOK 1374 PAGE 62
REDRAW THIS SECTION
ELLIS TO CHICAGO
B.M. — * 82-213 TRK SPIKE IN 18" MAPLE S.S. JOY RD 77' E OF MARLOWE → 131.42
B.M. — * 82-212 NAIL IN LT POLE N.W. COR JOY & ROBSON → 138.18
B.M. — NAIL IN POLE S.W. COR ELLIS & ROBSON → 135.59
5'-0" WKS 1 FT OFF P.L.
REC 137.40
JOB-NO-D-1126
DESIGNED BY
DRAWN BY
TRACED BY
CHECKED BY
APPROVED
ENGINEER OF STREETS
CITY ENGINEER