DEPARTMENT OF PUBLIC WORKS DETROIT

CITY ENGINEER'S OFFICE — DIVISION OF PAVING DESIGN

STREET PAVING PLAN

SEWER O.K. J. Riepen	JOB NO.		PROGRESS	
INDEXED	BLUE PRINT ISSUED FOR:	DATE	START	FINISH
REVISIONS	GRADE ONLY			
	CATCH BASINS			
	PAVING-CLASS-			
	DEPT. OF WATER SUPPLY			
	GAS CO.			

QUANTITIES	LOTS	CITY	LOTS	CITY
EXCAVATION				
STRAIGHT CURB NEW				
OLD CURB RESET				
CIRCULAR CURB				
PAVING				
CONCRETE BASE				

HOR. SCALE	1" = 100'
VER SCALE	1" = 2'
BOOK	1377 PAGE 30
DATE	9-20-40
PLAN CHECKED	F.M.
PROFILE GRADE	F.M. / M.J.M.
COMPUTED CHECKED	R.S

LOTS 2L	1	404 00	✓ LENGTH	702	00
CITY 2L		40 00	✓ LENGTH	20	00
TOTAL 2L	1	444 00	✓ LENGTH	722	00
				LOTS	CITY
COST ADVERTISING BLANKS					
COST INSPECTION					

DESIGNED BY	M.J. MORGAN
DRAWN BY	F. Minikel
TRACED BY	
CHECKED BY	R.R.R.

APPROVED
S. L. Barton
J. D. Wallace
ENGINEER OF STREETS
Martin P. Fisher
ASSIST. CITY ENGINEER

CARD NO

INDEX NO	TOPO NO
69	100

RECORD NO

NAME OF STREET RUTLAND AVE. 60' Wde

FROM ~~P.M. R.R.~~ N.L. WESTFIELD

TO W. CHICAGO - S.L.

TYPE OF PAVEMENT

WIDTH 30'

NUMBER OF SHEETS 1

SHEET NO 1

Requested by D.P.W. 11-2-44.

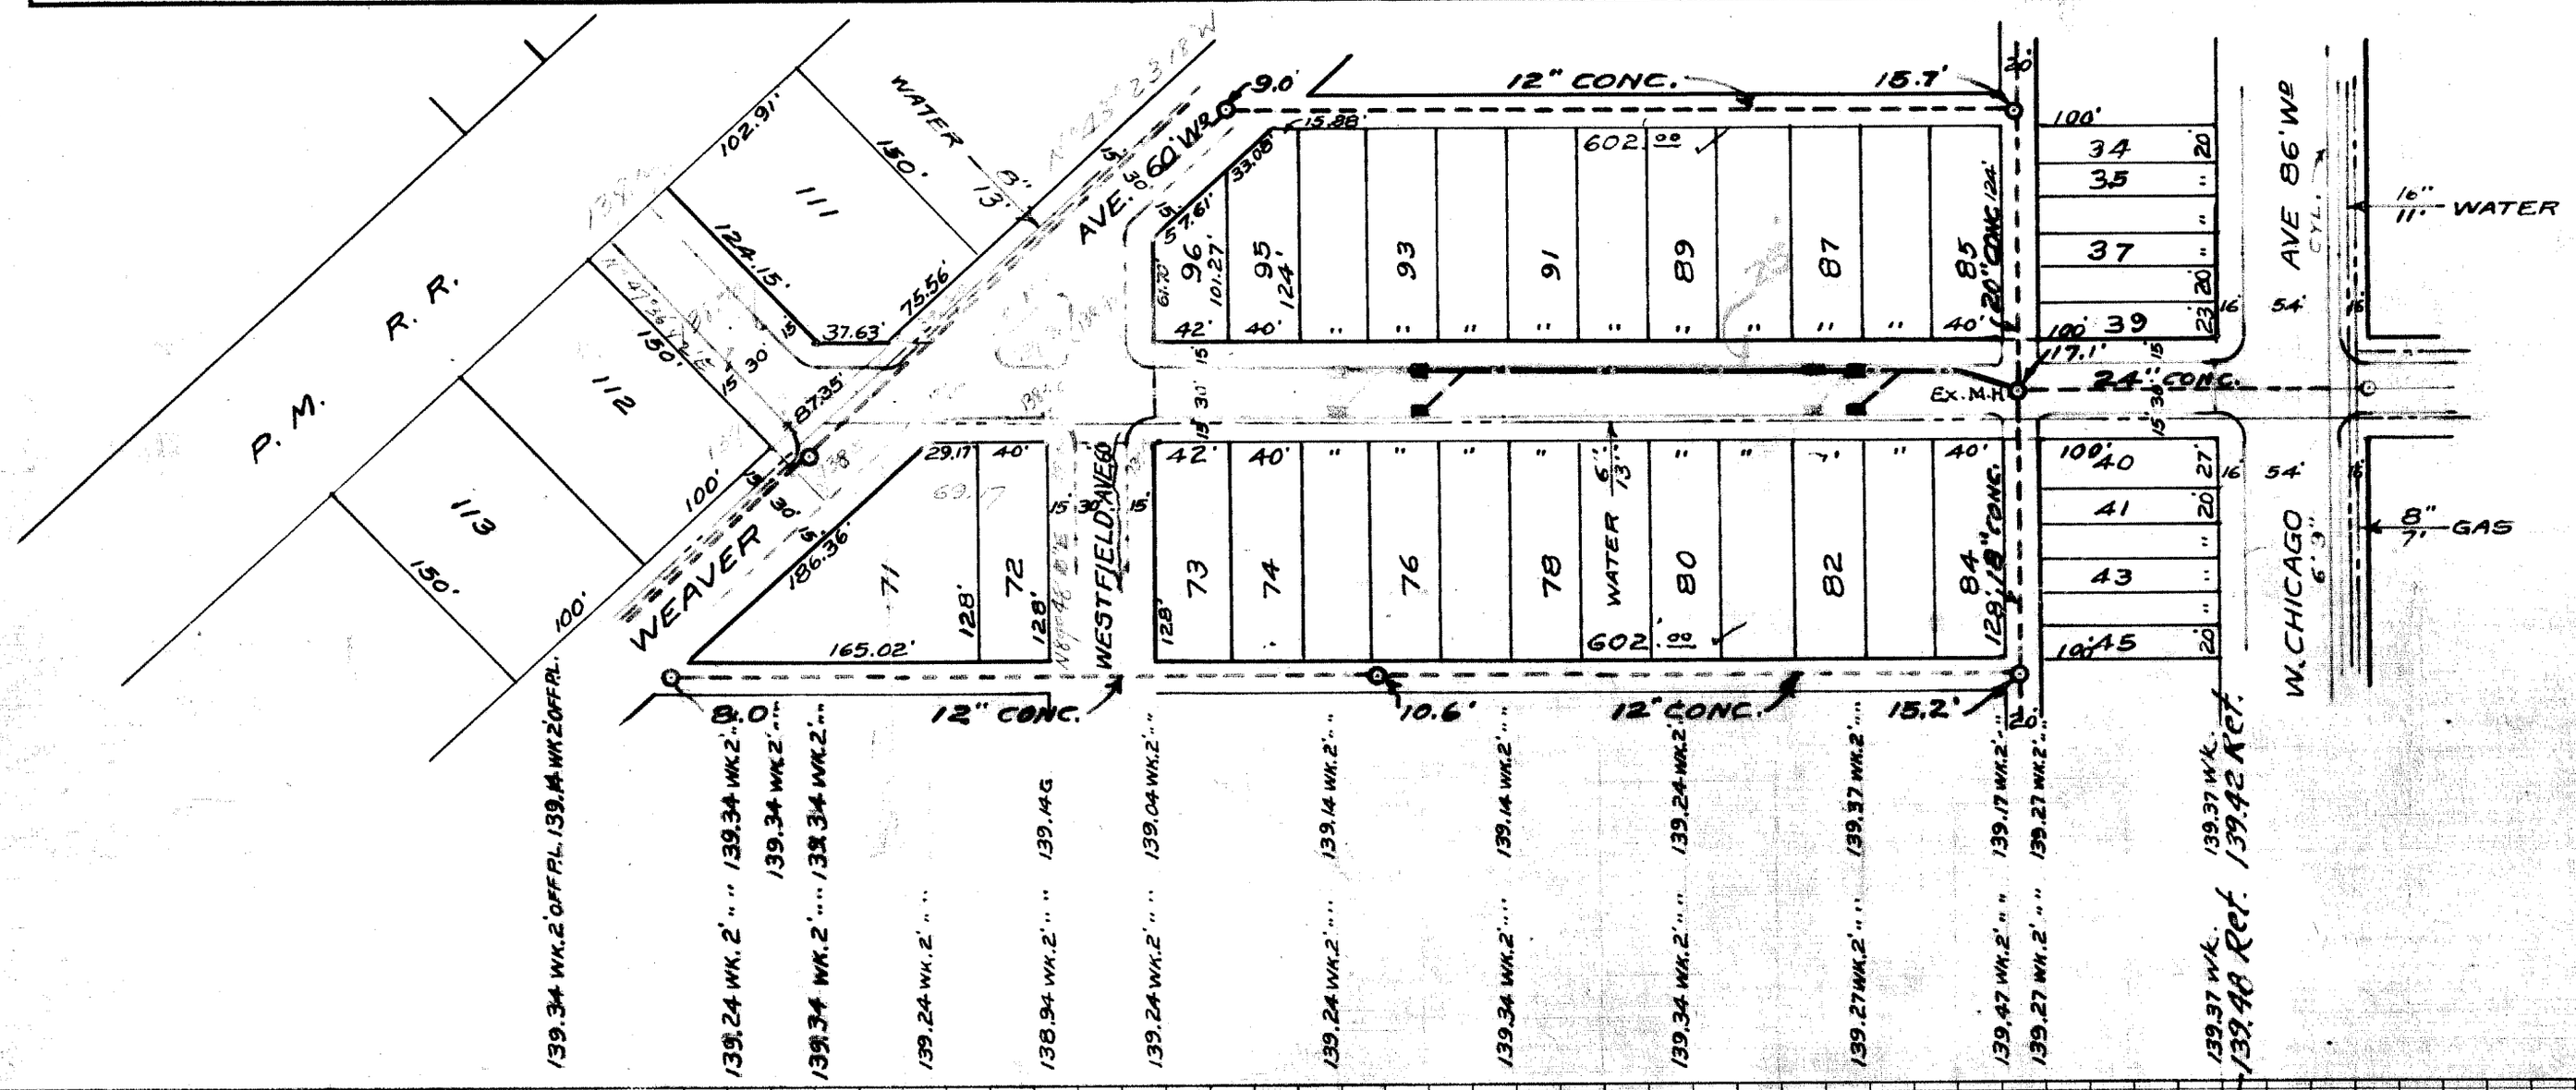

BENCH MARKS

100.206 100' E. SOUTHFIELD 200' S. OF W. CHICAGO IS A CROSS ON W. END OF CULVERT UNDER P.M.R.R. ELEVATION ---------- 140.031
SPK. IN E. SIDE TELL. POLE 15' N. OF RUTLAND ON N. P.M.R.R. P.L. ---- 141.436
ARROW ON HYD. N.E. COR. RUTLAND & W. CHICAGO ---------- 142.566
100.304 N. SIDE W. CHICAGO 50' W. OF MEMORIAL SPK. IN S. SIDE OF 30" ELM TREE -- 141.796

DRAINAGE COMPLETED.....
PAVING COMPLETED.....
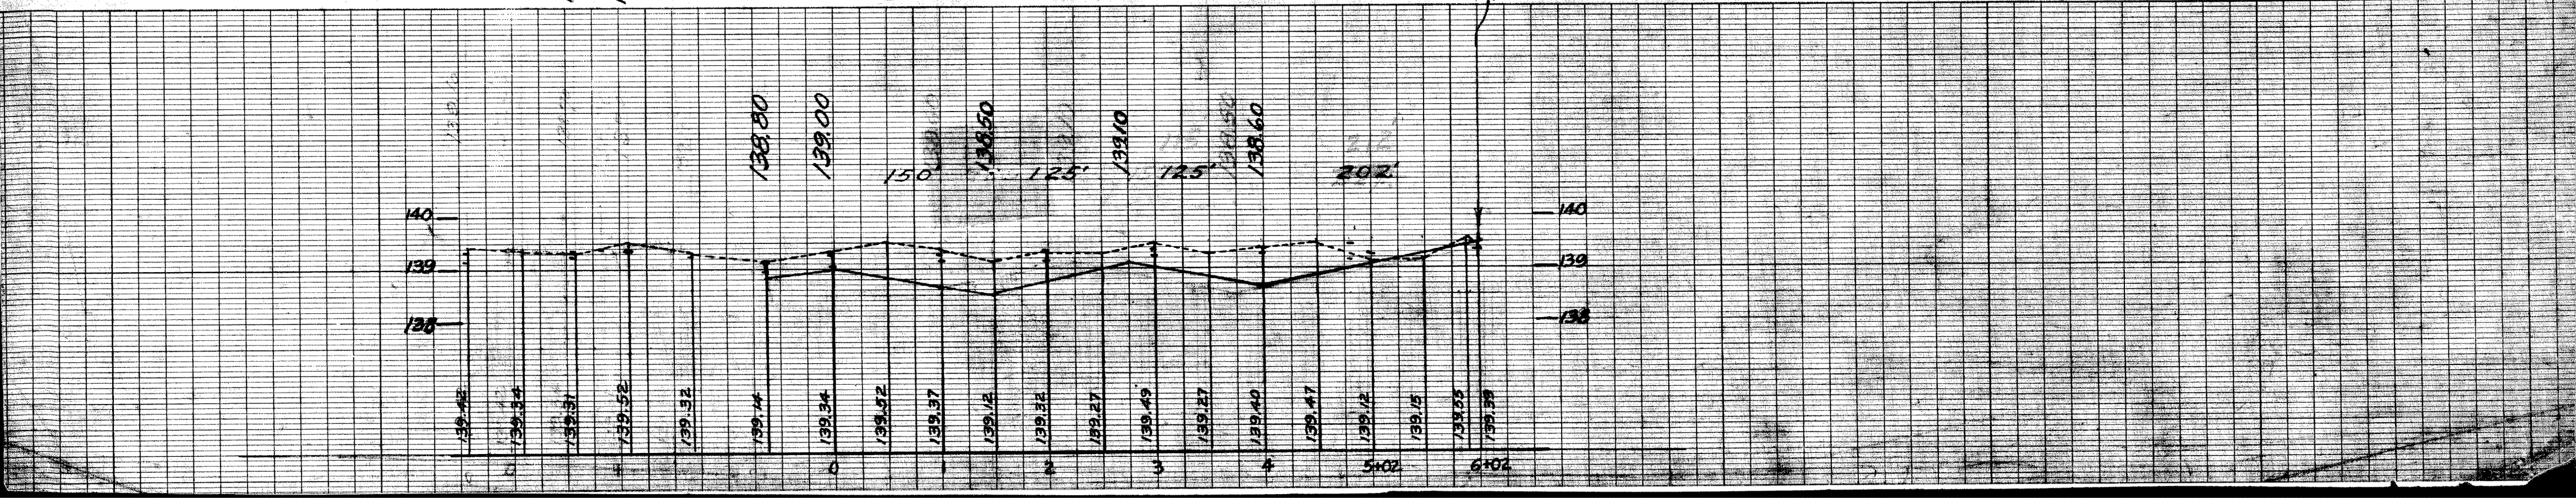
JOB-NO-D-1133