12C1
5 49/12
25P-4/15/9

SEWER OK Bldg-22-46

REVISIONS

18-15-48 Grade & Notes. L.G.V.T.

SUPPLEMENTARY DETAILS

DRAWING NO.

NOTE:
BEFORE STARTING CONSTRUCTION CONTRACTOR MUST CHECK WITH UTILITIES FOR LOCATIONS OF EXISTING STRUCTURES WHETHER OR NOT INDICATED ON PLANS

PLAN SCALE DISTORTED

LOTS & ALLEYS 1" = 100'
STREET WIDTHS 1" = 50'

ALL DRAINAGE COMPLETED 34 D.P.W. 6-5-46

PAVING COMPLETED C.C. 7-1-49

QUANTITIES		ESTIMATED LOTS	ESTIMATED CITY	FINAL LOTS	FINAL CITY
EXCAVATION CU. YDS.		2221 ✓	523 ✓	2221	523
NEW CURB II LIN. FT.		4 ✓	72 ✓	4	76
PAVING 8:6:8 SQ. YDS.		5110 ✓	138 ✓	5110	138
SIDEWALK STD. 4" SQ. FT.		1272 ✓	1302 ✓	1272	1340
			4W 38		38
MANHOLES	ADJUST		3 ✓		3
	CONE RECONSTRUCT		1 ✓		1
BASINS	ADJUST		10 ✓		10
	CONSTRUCT		1 ✓		1
SEWERS 12" LIN. FT.			63 ✓		63
REMOVE TREES 4"-12" 6" CONC. DR.			2 ✓		2
8" UNIF.			100 ✓		100
9" UNIF.		1	654 ✓		654
9" UNIF.		14 ✓	242 ✓	14	253

HOR. SCALE 1" = 50' | VER. SCALE 1" = 100' | BOOK 1599 PAGE 39 | DATE 3-25-46

PLAN	P.M.	PROFILE	P.M.	COMPUTED	R.E.R.
CHECKED	R.E.R.	GRADE	P.M.	CHECKED	S.S.

	LOTS	CITY	LENGTH	
	2928 61 ✓		1464 30 ✓	
	353 — ✓		176 50 ✓	
TOTAL	3281 61 ✓		1640 80 ✓	
COST ADVERTISING				
COST INSPECTION				

DESIGNED BY Reem
DRAWN BY P. MATSUMURA
TRACED BY P.M.
CHECKED BY Senton REEM

APPROVED
J. L. Burton
W. J. Wallace
ENGINEER OF STREETS
Martin A. Fisher
ASSISTANT CITY ENGINEER

CONTRACT NO. P.W. 824

DEPARTMENT OF PUBLIC WORKS DETROIT

CITY ENGINEER'S OFFICE --- DIVISION OF PAVING DESIGN

STREET PAVING PLAN

325 P- 8

CARD NO.

INDEX NO.	TOPO NO.
77	III

RECORD NO.

49-12

ASSIGNMENT NO. ~~7042-A~~

NAME OF STREET **STOUT**

FROM 36.5' S. OF N.P.L. OF PLYMOUTH ✓

TO S. P. L. OF WADSWORTH ✓

SHEET 1 OF 2 SHEETS

TYPE OF PAVEMENT 8"-6"-8" ONE COURSE CONCRETE SLAB AND CURB INTEGRAL — WIDTH 30'-36' ✓

PET. # 4186 E.A. PARKINSON 12/14/48

~~APPLICATION # 248-49 2-18-46~~

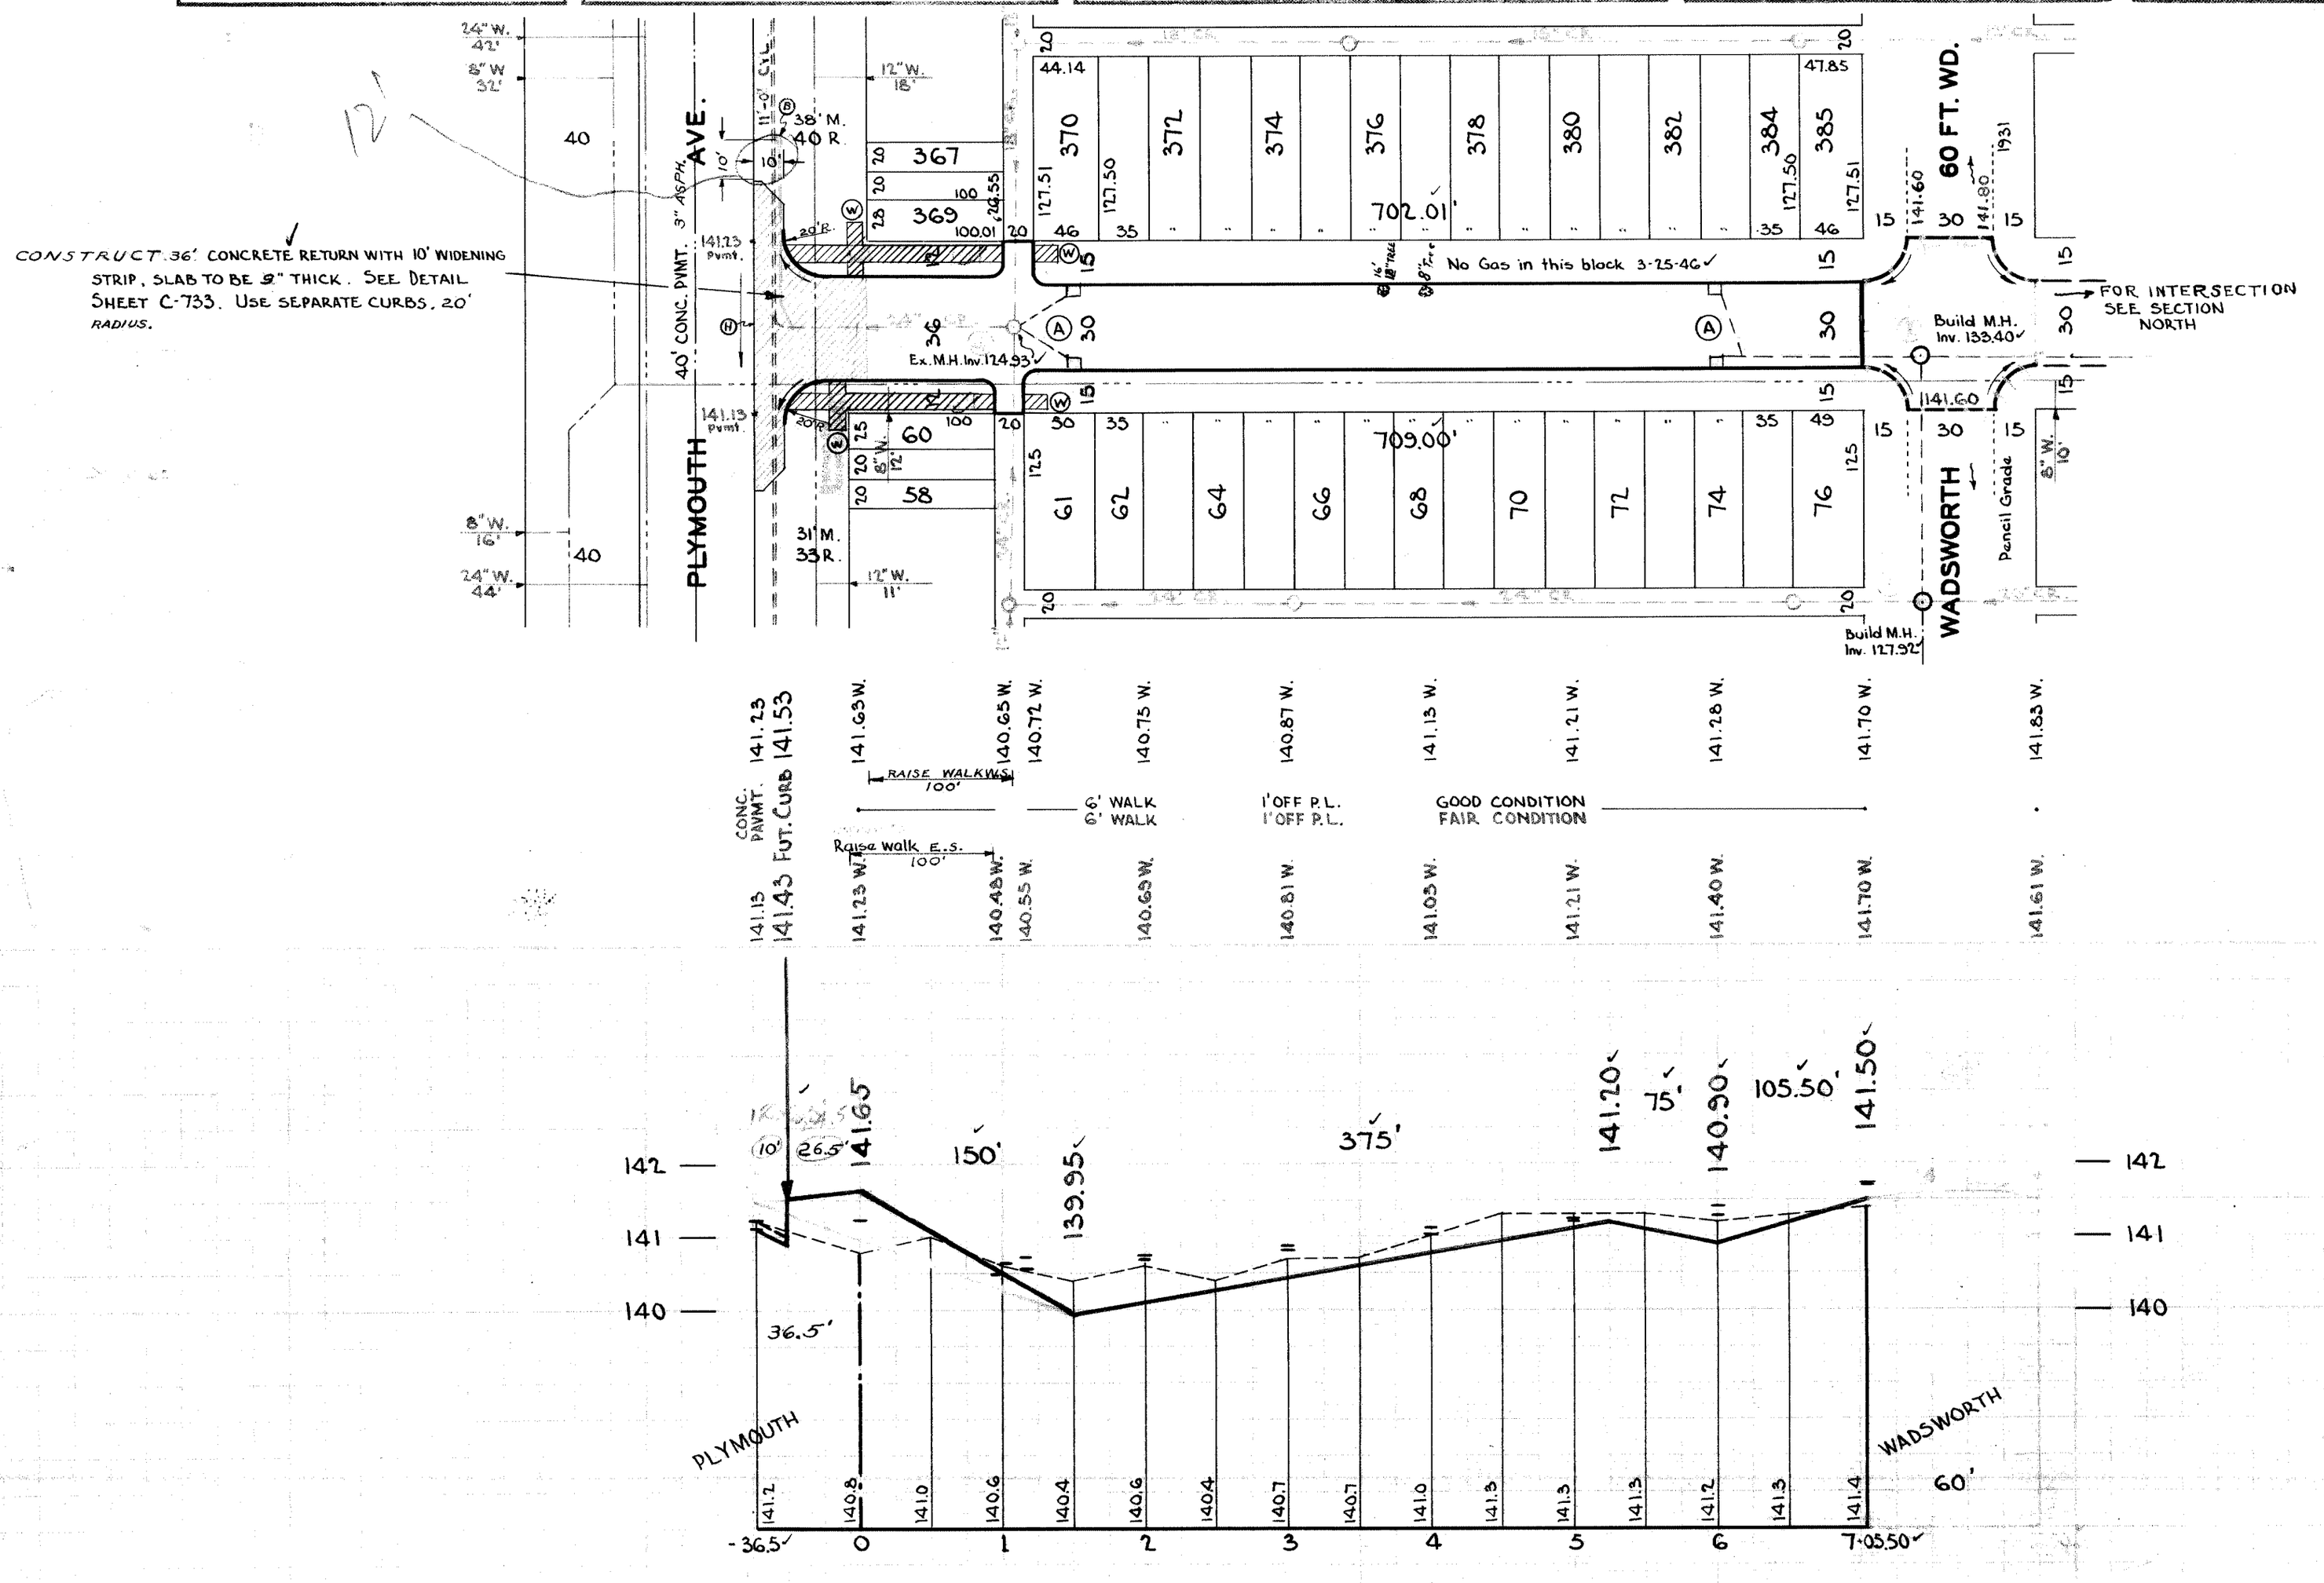

BENCH MARKS

	ELEV.
P.L.B.M. # 111.254 Conc. monument in handhole. N.E. corner of Plymouth and Evergreen.	142.159 ✓
Arrow on hydrant. N.E. cor. Stout and Plymouth.	144.04 ✓
"D" in Dept. Water gate at N.E. cor. Stout & Wadsworth.	141.53 ✓
P.L.B.M. # 111.255A Conc. monument in handhole. N.E. cor. of Evergreen and Fitzpatrick.	142.133 ✓

NOTES:

✓ AT (W) CONSTRUCT 1806 SQ. FT. OF STANDARD 4" SIDEWALK.
✓ AT (A) ADJUST TOPS OF 4 EXISTING 18"X12" Y BASINS WITH FLAT TYPE GRATES & FRAMES.
✓ AT (B) CONSTRUCT 1 STD. 18"X12" Y DOME TYPE BASIN COMPLETE & CONNECT TO EXISTING OUTLETS AS SHOWN.
✓ AT (H) CONTRACTOR SHALL REMOVE CONCRETE HEADER & BROKEN ASPHALT BACK OF JUNCTION AS REQUIRED & FILL WITH COLD PATCH TO MEET NEW GRADES. 10 CU. YDS. INCLUDED UNDER EXCAVATIONS TOTALS FOR COST.
✓ ADJUST TOPS OF 2 WATER MANHOLES.
✓ BACKFILL SEWER PIPE TRENCH UNDER PROPOSED PAVEMENT WITH APPROVED SAND GRAVEL MATERIAL, OTHERWISE FILL & TAMP WITH APPROVED EARTH LAYERS AS REQUIRED.
✓ CONTRACTOR TO GRUB & REMOVE 1-12"-6"-8" TREES AS INDICATED ON PLAN.
✓ DIRT ALLEYS - AT ENDS OF PAVEMENT SHALL BE GRADED BACK & STONED 6" DEEP UNIFORMLY, FOR A DISTANCE OF 10' TO MEET EXISTING GRADES. 24 CU. YDS. ARE INCLUDED UNDER EXCAVATION TOTALS FOR COST.
CONTRACTOR SHALL FURNISH ALL NECESSARY MATERIALS, INCLUDING
✓ CASTINGS & SHALL HAUL ALL SALVAGEABLE MATERIALS TO D.P.W. YARD AT STATE FAIR & JOHN R STS.
✓ ADJUST TOP OF 1 SEWER MANHOLE.
✓ RECONSTRUCT CONE OF 1 SEWER MANHOLE.
✓ RAISE WALK ON E. SIDE OF STOUT BETWEEN STA. 0+00 TO STA. 1+00
✓ RAISE WALK ON W. SIDE OF STOUT BETWEEN STA. 0+7 TO STA. 1+07
✓ RAISE WALK 12 FT ON EACH SIDE OF STOUT, ON N. SIDE OF PLYMOUTH TO MEET NEW GRADE.

SEE Plymouth Dwg. XIII 6-21-49
F.B. 962 pg 69 6-17-49
R.W.M. 6-27-49

410652