SEWER OK 4-6-45

REVISION GRADE REVISED FROM STA. 2 TO STA. 9 INCL. 3-12-47

SUPPLEMENTARY DETAILS

DRAWING NO.

NOTE:
BEFORE STARTING CONSTRUCTION CONTRACTOR MUST CHECK WITH UTILITIES FOR LOCATIONS OF EXISTING STRUCTURES WHETHER OR NOT INDICATED ON PLANS.

PLAN SCALE DISTORTED

LOTS & ALLEYS 1" = 100'

STREET WIDTHS 1" = 30'

DRAINAGE COMPLETED

PAVING COMPLETED

QUANTITIES		ESTIMATED LOTS	ESTIMATED CITY	FINAL LOTS	FINAL CITY
EXCAVATION	CU. YDS.	1 746	63		
NEW CURB	LIN. FT.	2 390	69		
PAVING	SQ. YDS.	4 010	122		
SIDEWALK	SQ. FT.	—	144		
MANHOLES	ADJUST		1		
	CONSTRUCT		—		
BASINS	ADJUST				
	CONSTRUCT		8		
SEWERS-12"	LIN. FT.		716		
SEWERS-15"	LIN. FT.				

HOR. SCALE	1" = 100'			BOOK	1581	PAGE	13
VER. SCALE	1" = 2'			DATE	4-5-45		
PLAN CHECKED	F.J.G	PROFILE GRADE	G.S	L.G.V.T. COMPUTED	G.S	P.M. CHECKED	G.S
LOTS 2L	2 405 95			LENGTH	1 202 98		
CITY 2L	36 00			LENGTH	18 00		
TOTAL 2L	2 441 95			LENGTH	1 220 98		
					LOTS		CITY
COST ADVERTISING							
COST INSPECTION							

DESIGNED BY G.S

DRAWN BY L.G. VAN TUYL

TRACED BY

CHECKED BY Seaton

APPROVED

J. L. Barton

W. J. Wallace
ENGINEER OF STREETS

Martin R. Fisher
ASSIST. CITY ENGINEER

CARD NO.

INDEX NO. 78 | TOPO NO. 109

RECORD NO.

DEPARTMENT OF PUBLIC WORKS DETROIT

CITY ENGINEER'S OFFICE --- DIVISION OF PAVING DESIGN

STREET PAVING PLAN

A.P. 61-1308

NUMBER OF SHEETS 1

SHEET NO. 1

NAME OF STREET **STOUT**

FROM N.P.L. OF SAWYER AVE.

TO S.P.L. OF TIREMAN AVE.

TYPE OF PAVEMENT DRAINAGE WIDTH 30'

Requested by Weber 3/6/47
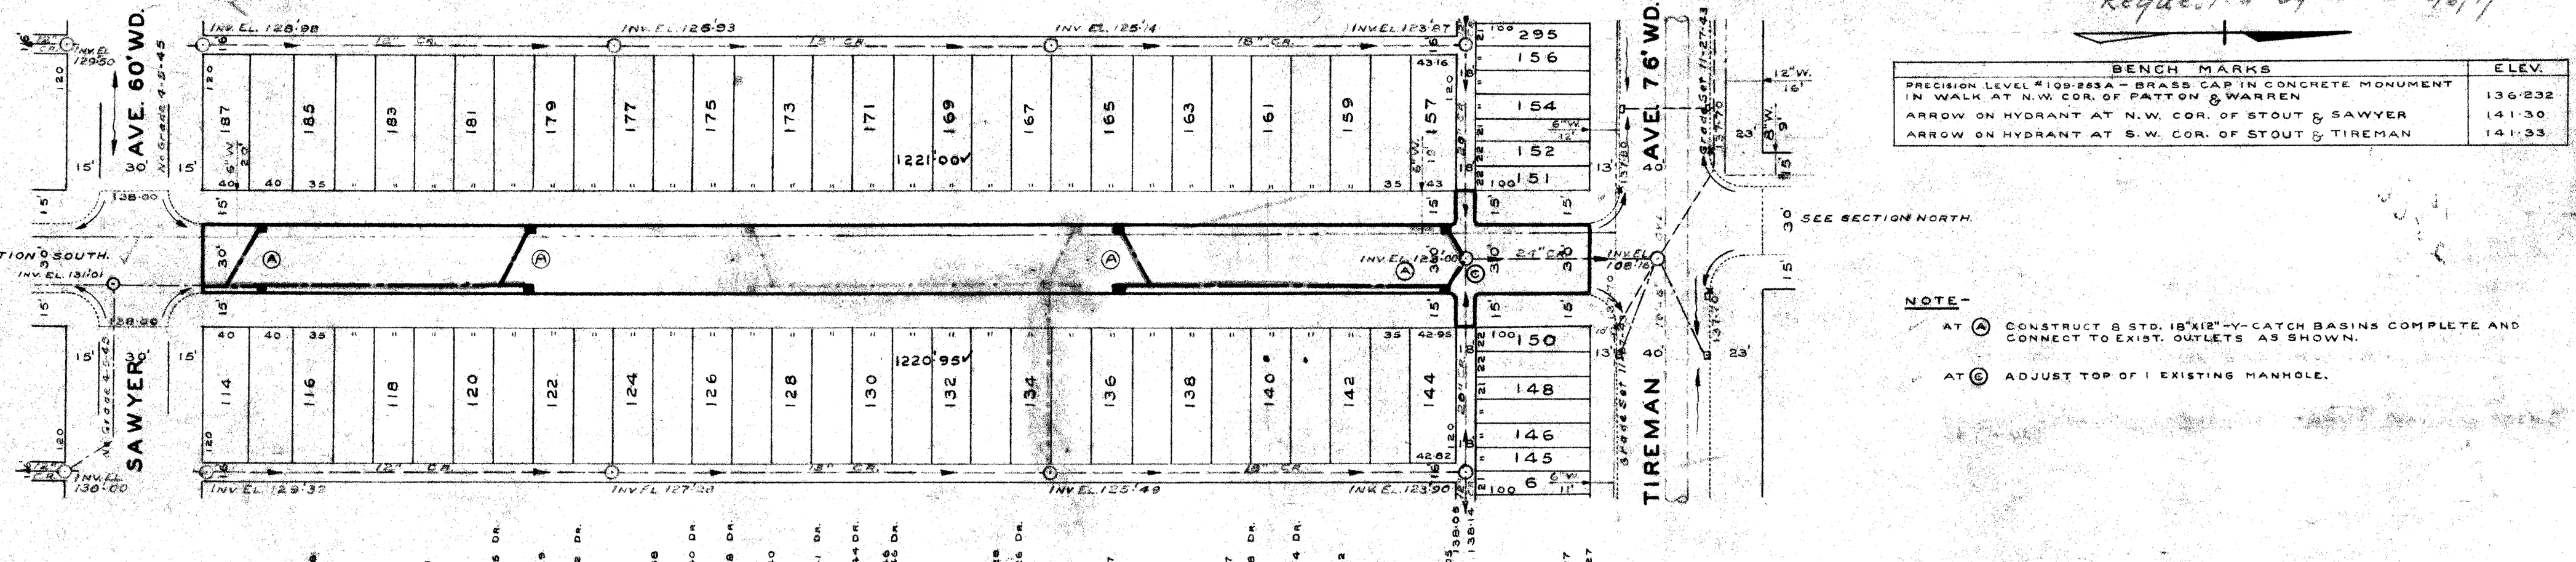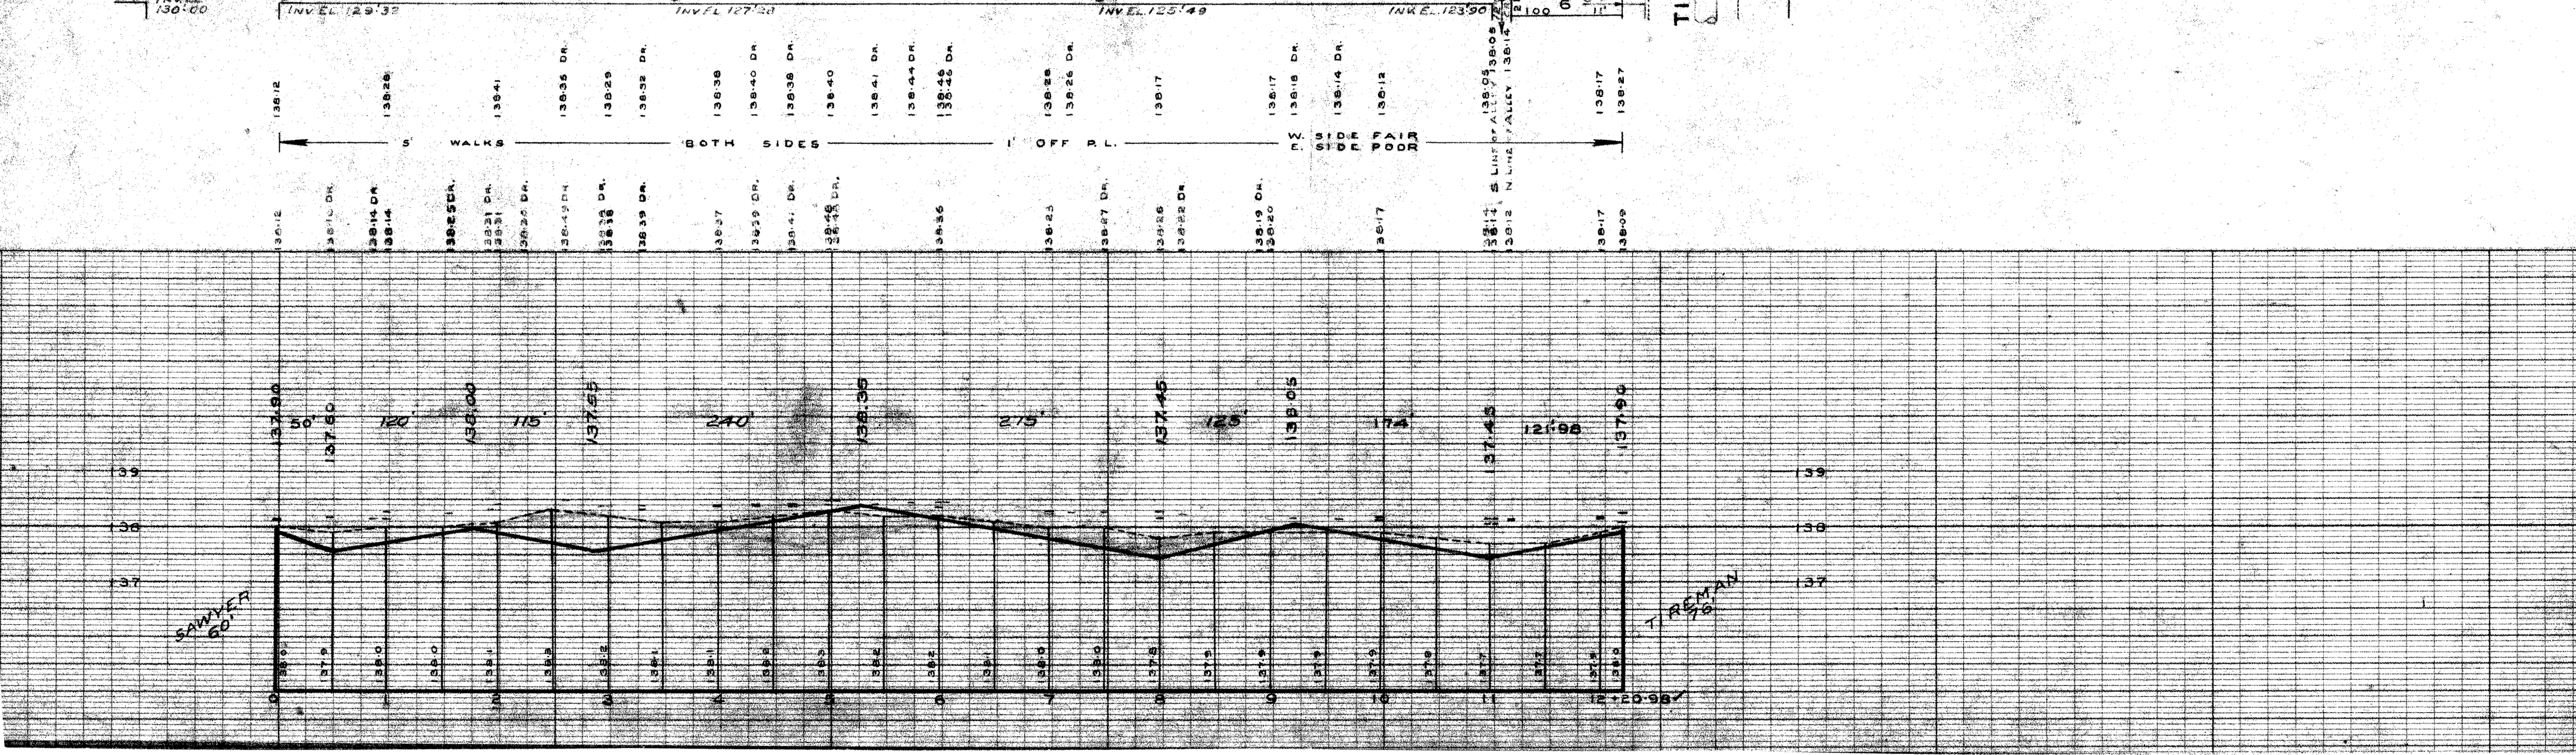
BENCH MARKS	ELEV.
PRECISION LEVEL #109-283A – BRASS CAP IN CONCRETE MONUMENT IN WALK AT N.W. COR. OF PATTON & WARREN	136.232
ARROW ON HYDRANT AT N.W. COR. OF STOUT & SAWYER	141.30
ARROW ON HYDRANT AT S.W. COR. OF STOUT & TIREMAN	141.33