Sewers O.K.
JL

SUSSEX AVE.

N.L PURITAN TO McNICHOLS (S.L.)

SERIES Q-Q

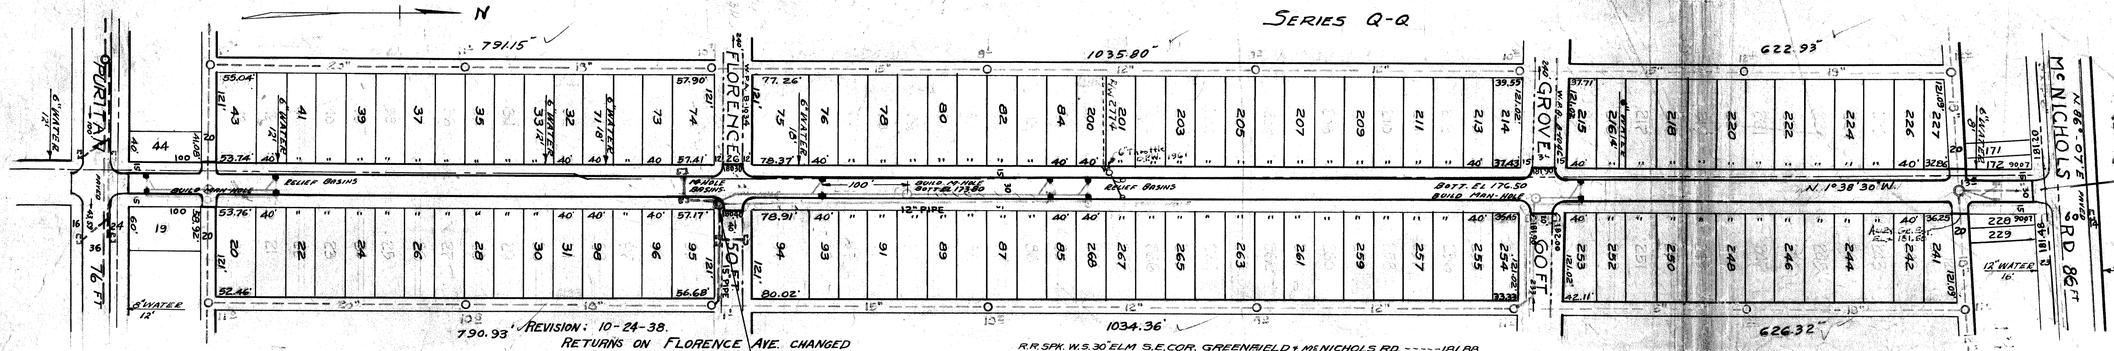

REVISION: 10-24-38.
RETURNS ON FLORENCE AVE. CHANGED FROM 30 FT. TO 26 FT.

CHECK BOTT EL. MAN-HOLE MUST BE NOT LESS THAN 171.20. CHECK SIZE OF PIPE M.H. TO M.H.

R.R. SPK. W.S. 30" ELM S.E. COR. GREENFIELD + McNICHOLS RD. ----- 181.88
SPK. IN 15" ELM S.E. COR. COYLE + McNICHOLS RD. ----- 183.30
SPK. IN E.S. 24" MAPLE S.W. COR. SUSSEX + McNICHOLS RD. ----- 181.52
SPK. IN W. ROOT OF 18" OAK S.E. SUSSEX + GROVE ----- 183.34
SPK. IN E.S. POWER POLE S.W. COR. SUSSEX + FLORENCE ----- 180.88
SPK. IN TEL. POLE E.S. SUSSEX 100' N. OF PURITAN ----- 178.63

Sidewalks OK for Est. Grade Oct. 2, 1941

6' WALKS 1' OFF P.L.

410708

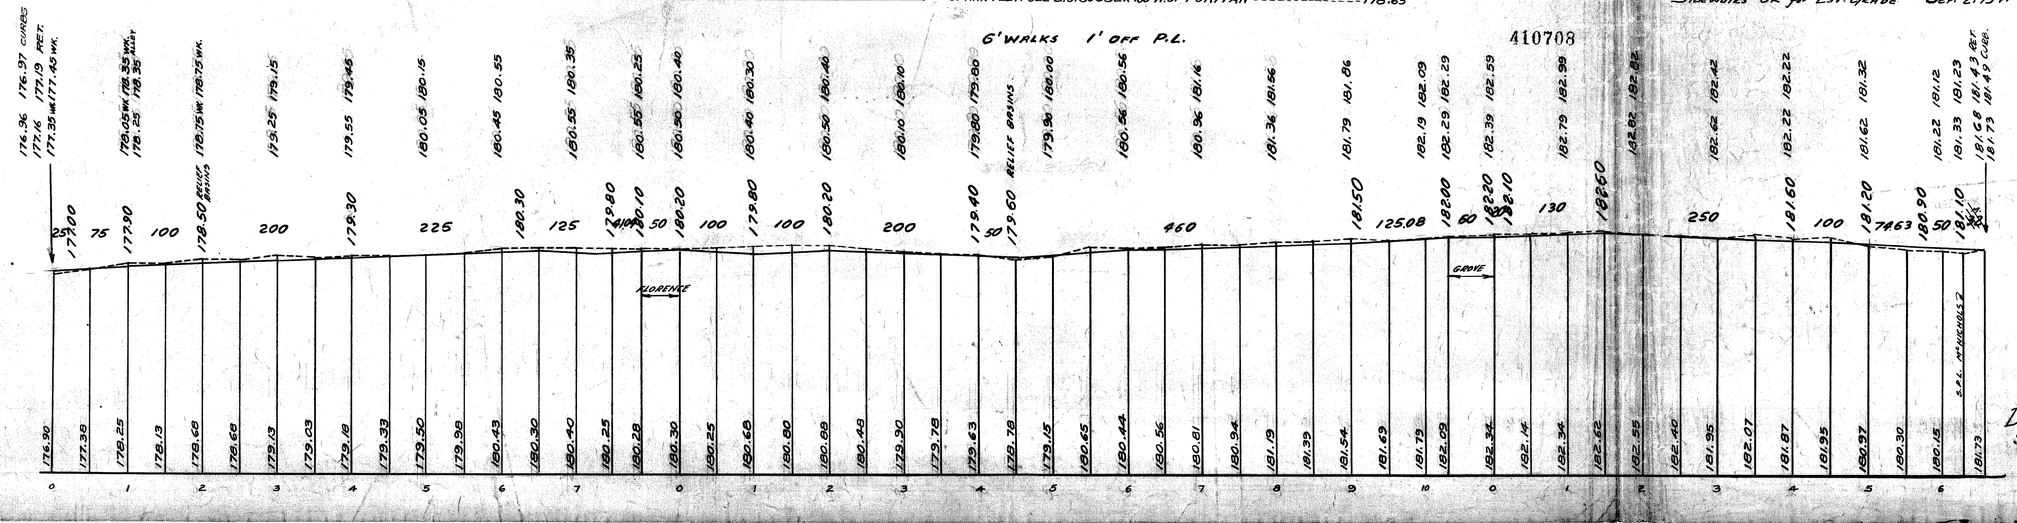

DEPARTMENT OF PUBLIC WORKS
CITY ENGINEER'S OFFICE
DETROIT, MICH.

INDEXED 5-26-38

SCALE: HOR. 1" - VER. 1" -	DATE 11/7/32
PLAN DRAWN BY	W.I.C.
PLAN CHECKED BY	L.R.
PROFILE DRAWN BY	W.I.C.
COMPUTATIONS MADE BY	
" CHECKED BY	
GRADE ESTABLISHED BY	F.G. 3/1/38

CIRCLES
A. 92°14.30"
R. 42
T. 12.59
A. 24.14

(Intersection W.C.R. 1941 Program)

CIRCLES
A. 87°45.30"
R. 15
T. 14.41
A. 22.97

B 10.40 P. 8	LOTS	CITY
Excavation		
N. C. Straight		
Old Curb Reset		
N. C. Mod. Circle by Contr.		
Paving		
" Concrete Base		
Curb Concrete		
Ret. Stone		
Conct. Header Sq. Yds.		

WATER MAINS OK 11/4/38

LOTS	" 4	821	49	½	" 2	410	75
CITY	"	300	—	¼	"	150	—
TOTAL	" 5	121	49		" 2	560	75

NOTE
NO GAS MAINS IN SUSSEX

		APPROVED
DESIGNED BY	F. Guillemety	Robt. R. Dean
DRAWN BY		W. J. Wallace
TRACED BY	F. Minikel	ENGINEER OF STREETS
CHECKED BY	F. Guillemety	Martin R. Fisher ASST. CITY ENGINEER

DRAINAGE COMPLETED 12-5-40
PAVING COMPLETED 6-13-42

JOB-NO. D-2038
Drainaage installed - Puritan to McNichols
spot check - 4-10-41 by H. Buckingham
see letter 4-11-41