1803P

DEPARTMENT OF PUBLIC WORKS DET. OF
CITY ENGINEER'S OFFICE — DIVISION OF PAVING DESIGN

STREET PAVING PLAN

# WEST PARKWAY

40' S. OF N.P.L. OF PLYMOUTH

199.42' N. OF N.P.L. OF WADSWORTH

30'&36'

51-17

77 119

325A24 7/38 7/34

1

411382

O.K. Jhigsal 9/24/51

GRADE STA. 7+90 TO STA. 0 AT N.W. CORNER WADSWORTH 6-19-52 J.E.

QUANTITY CHANGE 7-1-52 P.B.

GRADE CHANGE IN FIELD: STA. 0-40 TO 1+50. 9-22-52 W.R.Q.

QUANTITY CHANGE 9-22-52 W.P.R.

| SUPPLEMENTARY DETAILS | | | |
|---|---|---|---|
| C-324A | C-520 | C-537 | C-733B |
| C-325 | C-524 | C-733 | C-938 |
| C-325A | C-585 | C-739 | C-1608 |
| C-327 | C-596 | C-739A | |

PLAN SCALE DISTORTED
LOTS & ALLEYS 1"=100'
STREET WIDTHS 1"=50'

DRAINAGE COMPLETED 12-24-52

PAVING COMPLETED C.C. 12-30-52

TREE REMOVAL (SEE LOWER RIGHT CORNER THIS PAGE)

| QUANTITIES | ESTIMATES LOTS | ESTIMATES CITY | FINAL LOTS | FINAL CITY |
|---|---|---|---|---|
| EXCAVATION CU.YDS. | 1317 ✓ | 208 ✓ | | |
| NEW CURB LIN.FT. | | 79 ✓ | | |
| PAVING 8"C.C.B. SQ.YDS. | 4148 ✓ | 69 ✓ | | |
| 8" UNIF " | | 608 ✓ | | |
| 6" CONC. DR. S.FT | | 100 ✓ | | |
| SIDEWALK 4" SQ.FT. | | 888 ✓ 2W | | |
| CURB RAMPS CONST. | | 25 ✓ | | |
| CONE RECON. | | 1 ✓ | | |
| BASINS CONSTRUCT | | 8 ✓ | | |
| SEWER 12" LIN.FT. | | 555 ✓ | | |

| | | | |
|---|---|---|---|
| HOR. SCALE | 1"=100 | BOOK 1692 | PAGE 64 |
| VER. SCALES | 1"=2' | DATE C.C. 8-16-51 DRAWN 8-23-51 | |
| PLAN | RJA | PROFILE RJA | COMPUTED DB |
| CHECKED C.L. | GRADE 95 | CHECKED GB | |
| LOTS LIN. | 2359.32 ✓ | LENGTH | 1179.66 ✓ |
| CITY LIN. | 220.00 ✓ | LENGTH | 110.00 ✓ |
| TOTAL LIN. | 2579.32 ✓ | LENGTH | 1289.66 ✓ |
| COST COVER SHT. | | LOTS | CITY |
| COST INSPECTION | | | |

DRAWN BY R. J. ALBERTS
TRACED BY
CHECKED BY Sexton
APPROVED
CITY ENGINEER

PET "7138" FRISCHKORN BROS. 7-31-51 25% P.D. ✓
PET "7134" BILTMORE BLDG

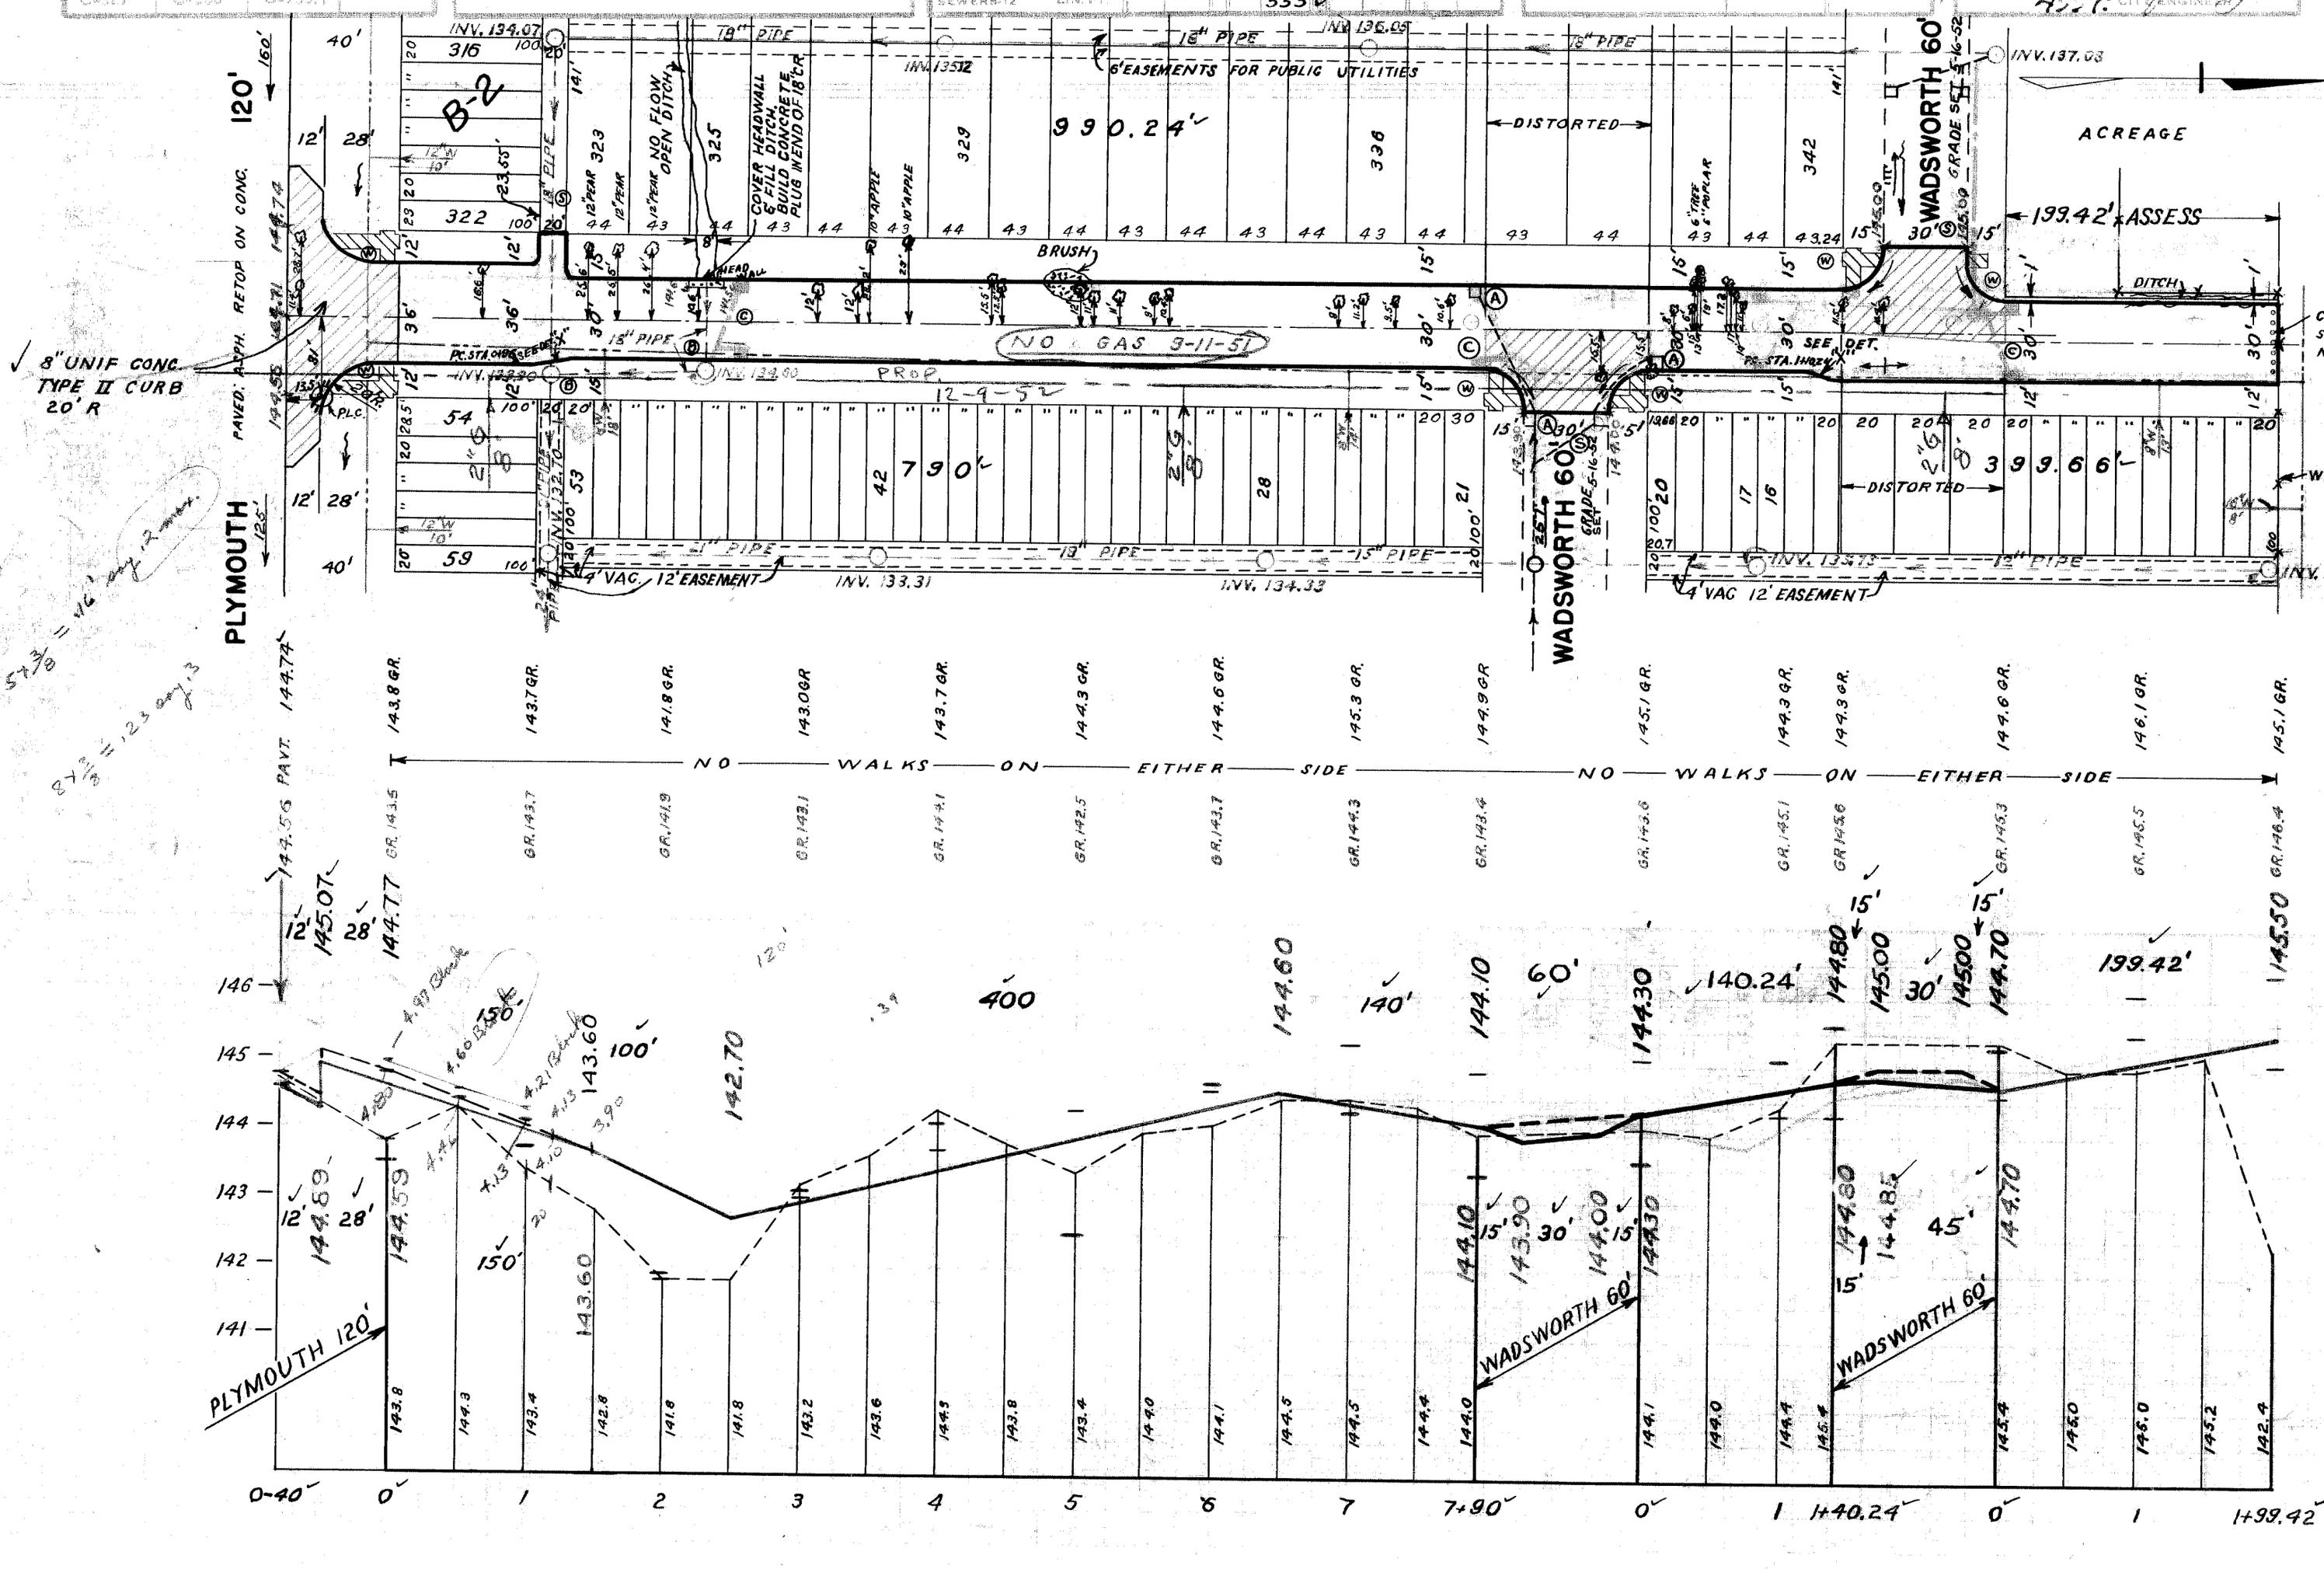


## BENCH MARKS

| | ELEV. |
|---|---|
| P.B.M. S.E. COR. W. PARKWAY & PLYMOUTH | 144.272 ✓ |
| B.M. SPIKE IN ED. POLE 1ST. S. OF G.M. PROP. FENCE IN ALLEY BET. BEAVERLAND & W. PARKWAY | 146.72 ✓ |
| B.M. SPIKE IN POLE 3RD POLE S. OF WADSWORTH IN EASEMENT EAST OF W. PARKWAY | 145.18 ✓ |

NOTE: FOR SYMBOLS Ⓐ ETC. SEE STD. DET. DRW'G NO. C-327

TREE REMOVAL SCHEDULE FROM PLYMOUTH TO WADSWORTH

| STA. | KIND | SIZE | NO. | STA. | KIND | SIZE | NO. |
|---|---|---|---|---|---|---|---|
| -35' | ELM | 24" | 1 | 4+34.5' | WILD CH. | 16" | 1 |
| -35' | ELM | 36" | 1 | 4+95' | CHERRY | 10" | 1 |
| +62' | BUTTERNUT | 6" | 1 | 5+02' | ELM | 4" | 1 |
| ~~1+36'~~ | ~~PEAR~~ | ~~12"~~ | ~~1~~ | 5+24.5' | CHERRY | 10" | 1 |
| ~~1+60'~~ | ~~PEAR~~ | ~~12"~~ | ~~1~~ | 5+51' | ELM | 40" | 1 |
| ~~1+85'~~ | ~~PEAR~~ | ~~12"~~ | ~~1~~ | 5+80.5' | CHERRY | 15" | 1 |
| 3+03' | CHERRY | 10" | 1 | 6+87' | CHERRY | 15" | 1 |
| 3+35' | CHERRY | 12" | 1 | 7+02' | ELM | 8" | 1 |
| ~~3+41'~~ | ~~APPLE~~ | ~~10"~~ | ~~1~~ | 7+27' | CHERRY STUMP | 12" | 1 |
| ~~3+74'~~ | ~~APPLE~~ | ~~10"~~ | ~~1~~ | 7+67' | ELM | 20" | 1 |
| 4+31' | CHERRY | 10" | 1 | 8+39.5' | POPLAR | 4" | 1 |

QUANTITY CHANGE #1
DUE TO GRADE CHANGE 7-1-52
CITY: EXCAVATION -106 CU.YDS.

Change water main 9/3/52

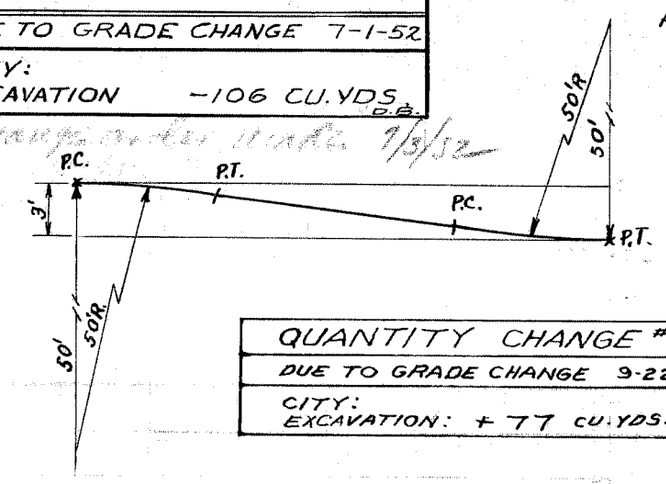


QUANTITY CHANGE #2
DUE TO GRADE CHANGE 9-22-52
CITY: EXCAVATION: +77 CU.YDS.

LEGEND
P.L.C. POLE ⊙

DUTCHMAN
3' OFFSET IN 30'
R. = 50' ✓
Δ = 7°12'15" ✓
T = 3.15' ✓
A = 6.28' ✓
S = 25 SQ. FT.
DET. "X" SCALE 1"=10'

| LOTS-QUANTITIES | | | CITY |
|---|---|---|---|
| TREE REMOVAL | | NO | |
| 4"-12" | EA. | 19 ✓ | 1 ✓ |
| 12"-18" | EA. | 4 ✓ | — |
| 20" | EA. | 1 ✓ | — |
| 24" | EA. | — | 2 ✓ |
| 36" | EA. | 1 ✓ | — |
| 40" | EA. | 1 ✓ | — |

TREE REMOVAL SCHEDULE FROM WADSWORTH TO WADSWORTH

| STA. | KIND | SIZE | NO | STA. | KIND | SIZE | NO |
|---|---|---|---|---|---|---|---|
| +03' | POPLAR | 10" | 1 | ~~+58'~~ | ~~POPLAR~~ | ~~5"~~ | ~~1~~ |
| +19' | POPLAR | 8" | 1 | +60' | POPLAR | 4" | 1 |
| +32' | ASH | 6" | 1 | +61.5' | POPLAR | 14" | 1 |
| +33.5' | POPLAR | 5" | 2 | +69.5' | POPLAR | 4"&6" | 2 |
| +35.5' | | 8" | 1 | 1+47' | ELM | 24" | 1 |
| ~~+36'~~ | | ~~6"~~ | ~~1~~ | 1+76' | | 6" | 1 |