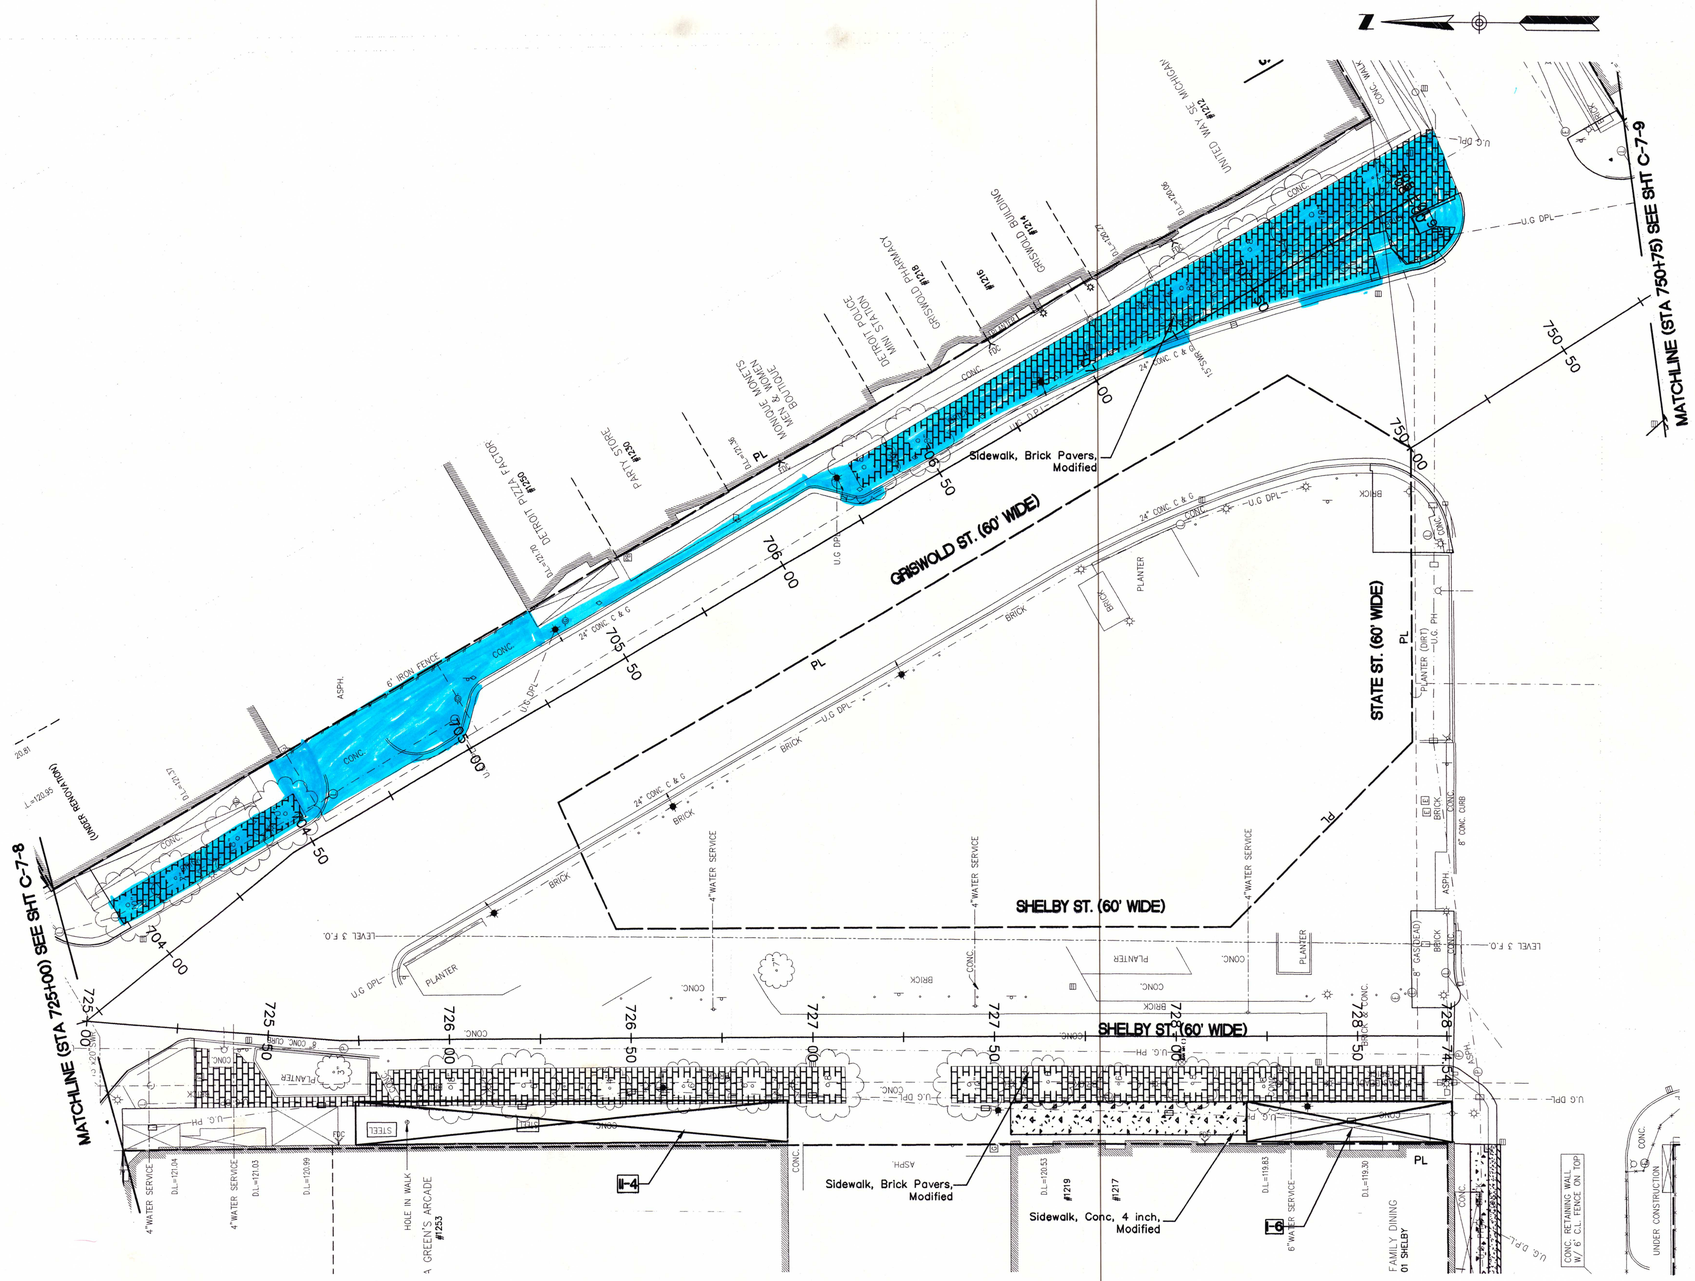

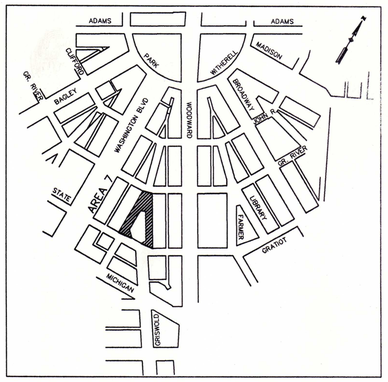

KEY PLAN

CONSTRUCTION LEGEND

- Sidewalk, Conc, 4 inch, Modified
- Sidewalk, Conc, 6 inch, Modified
- Integral Curb and Sidewalk, Conc, 4 inch, Modified
- Integral Curb and Sidewalk, Conc, 6 inch, Modified
- Integral Curb and Sidewalk, 2 Feet, Modified
- Conc Pavt, Misc, Nonreinf, 8 inch
- Hand Patching
- Brick Paving, Modified
- LIMITS OF CONSTRUCTION ON CROSS STREET
- PROPERTY LINE

NOTE:
FOR SIDEWALK CONSTRUCTION OVER VAULTS DETAILS SEE SHT # X-1.

NON PARTICIPATING QUANTITIES, THIS SHEET

PAY ITEM	UNIT	QUANTITY
Integral Curb and Sidewalk, 2 Feet, Modified	Ft	–
Sidewalk, Conc, 4 inch, Modified	Sft	594
Sidewalk, Conc, 6 inch, Modified	Sft	–
Conc Pavt, Misc, Nonreinf, 8 inch, Modified	Syd	–
Hand Patching	Ton	–
Sidewalk, Brick Pavers, Modified	Sft	5591

AS-BUILT

3 WORKING DAYS
BEFORE YOU DIG
CALL MISS DIG.
1-800-482-7171
For free location of public utility lines

BASE BID

F				
E				
D				
C				
B				
A				
	DESCRIPTION	CHK'D	APPV'D	DATE
	REVISIONS			

DRAWN BY:
DESIGNED BY:
CHECKED BY:
APPROVED BY:

LOWER WOODWARD CROSS STREETS IMPROVEMENTS
CITY OF DETROIT- DOWNTOWN DEVELOPMENT AUTHORITY

CONSTRUCTION PLAN
GRISWOLD (EAST + WEST) - MATCHLINE D-D TO MATCHLINE E-E

SCALE:1"=20'
DATE: 08-28-08

220 W. CONGRESS, SUITE 400
DETROIT, MI 48226
PHONE: (313) 967-4700
FAX: (313) 967-4707
www.spaldingdedecker.com

hamiltonanderson
Hamilton Anderson Associates
1435 Randolph Suite 200, Detroit, Michigan 48226
p 313 964 0270 f 313 964 0170
www.hamilton-anderson.com

NH
480 Ford Field, 2000 Brush Street
Detroit, MI 48226
PHONE: (313) 237-3900
FAX: (313) 237-3909
www.nhconsultants.com

Consulting Engineering Associates, Inc
16580 Wyoming Avenue,
DETROIT, MI 48221-2882
PHONE: (313) 341-5797
FAX: (313) 341-0205
www.consulteng.com

UES
20349 Alderton Street, Suite 200
DETROIT, MI 48219-9550
PHONE: (313) 434-8282
FAX: (313) 537-7945
www.urbanengineeringsolutions.com

MANSELL
Mansell Associates, INC.
33608 Grand River,
Farmington, MI 48335
PHONE: (248) 473-7070
FAX: (248) 473-8190

DDA
CITY OF DETROIT
DOWNTOWN DEVELOPMENT AUTHORITY
500 Griswold, Suite 2200,
Detroit, MI 48228
P: (313) 963-2940
F: (313) 963-8893

SECTION MAP	TOWN	RANGE	SECTION	PORTION CODE
– – – –	– –	– –	– – – –	– – – –

M.D.P.H./D.N.R. PERMIT NO.
REF. NO. DE06001.OT
CONTRACT NO.
FILE NO.
DRAWING NO. C-7-8