K&E 17 0153 12-73 9714

APPROX. 5466 CU. YDS. OF SELECTED EXC. MATERIAL IS NEEDED AS BACKFILL FOR THIS PROJECT.

CALL MISS DIG
48 HOURS PRIOR TO CONSTRUCTION 647-7344

REMOVAL LEGEND

- Street Pavement Removal - Reinforced
- Street Pavement Removal - Unreinforced
- Alley Pavement Removal
- Sidewalk Removal
- Driveway Removal
- R(Size) Tree Removal
- Sidewalk - 4"
- R(Size) Stump Removal
- Separate Curb - Reinforced - Type II Mod.*
- Sodding
- (E) Catch Basin - Abandonment
- (E)s Catch Basin - Special Abandonment
- (M) Manhole (Sewer), Abandonment
- (B) Manhole - Adjustment
- (R) Manhole - Reconstruct Cone
- Removing Guard Rail
- Steel Beam Guard Rail
- Single Beam Barrel Barricade

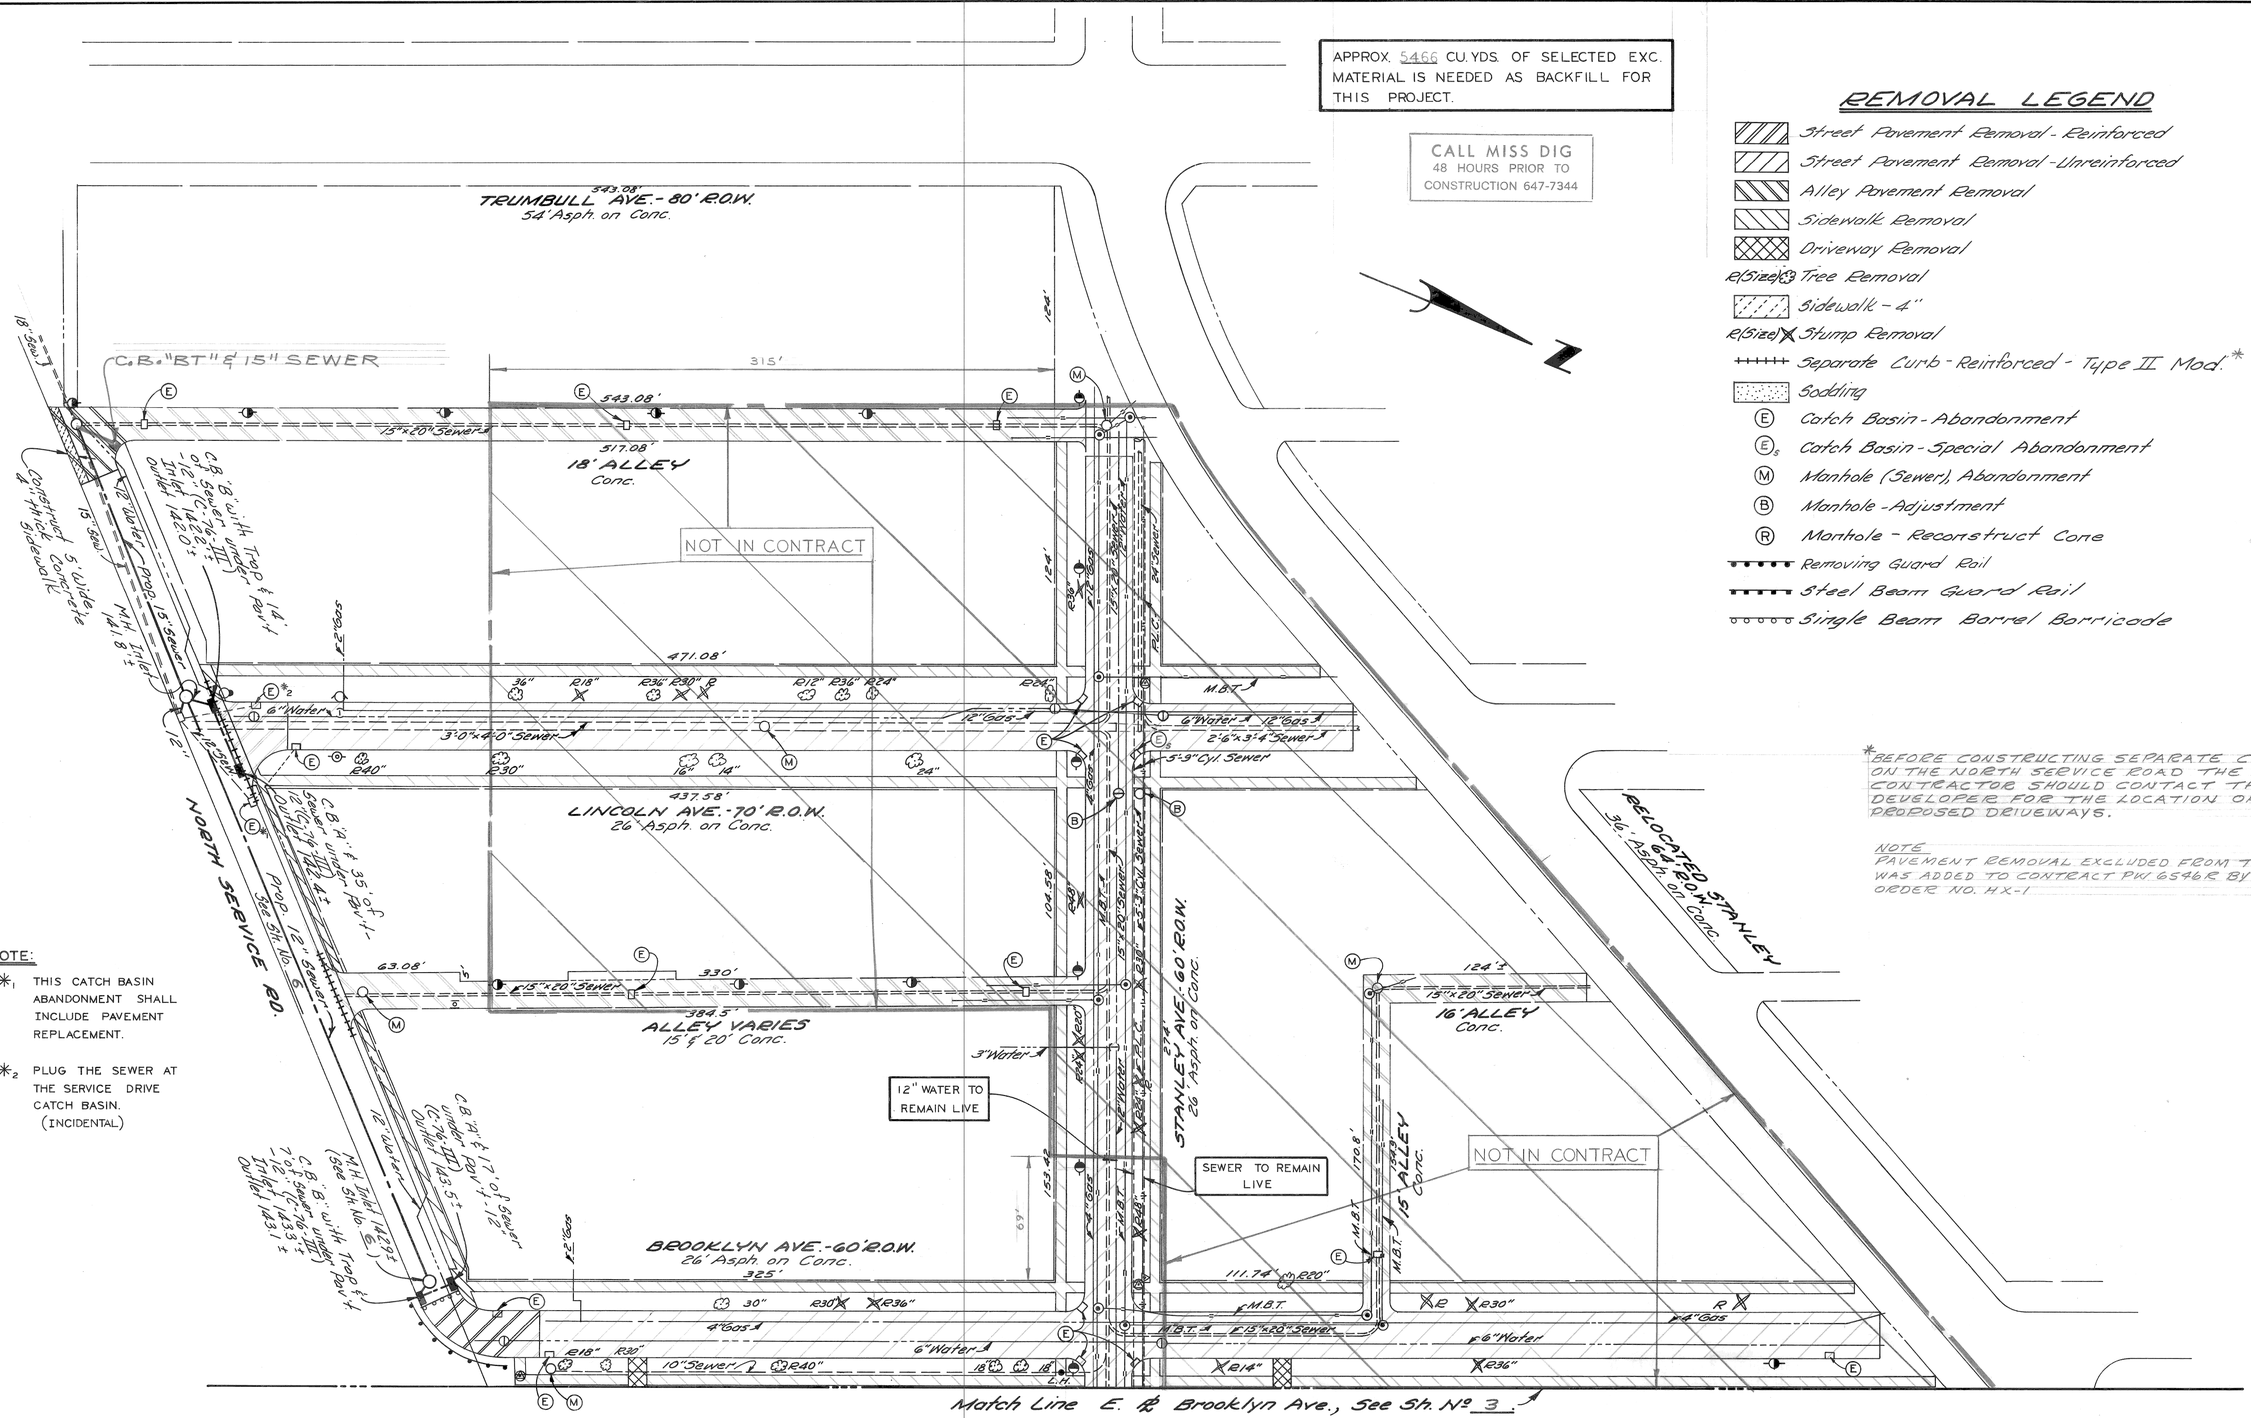

*BEFORE CONSTRUCTING SEPARATE CURB ON THE NORTH SERVICE ROAD THE CONTRACTOR SHOULD CONTACT THE DEVELOPER FOR THE LOCATION OF PROPOSED DRIVEWAYS.

NOTE
PAVEMENT REMOVAL EXCLUDED FROM THIS CONTRACT, WAS ADDED TO CONTRACT PW 6546E BY CHANGE ORDER NO. HX-1

NOTE:

*1 THIS CATCH BASIN ABANDONMENT SHALL INCLUDE PAVEMENT REPLACEMENT.

*2 PLUG THE SEWER AT THE SERVICE DRIVE CATCH BASIN. (INCIDENTAL)

AS BUILT

PLAN
Scale: 1" = 40'

CODE	DESCRIPTION	DATE
REVISIONS LOCATED BY COORDINATES ON SHEET		

REFERENCE DRAWINGS

DESIGNED BY
DRAWN BY M.S.
TRACED BY
CHECKED BY K.B.V.

APPROVED:
ENGINEER OF STREETS

CITY OF DETROIT
CITY ENGINEERING DEPARTMENT
FOR
COMMUNITY AND ECONOMIC DEVELOPMENT DEPARTMENT

PAVING OF THE W. LODGE SERVICE DRIVE CUL-DE-SAC, PAVEMENT REMOVAL AND MISC CONSTRUCTION RESEARCH PARK WEST REHABILITATION PROJECT MICH. R-88

REMOVALS AND MISCELLANEOUS CONSTRUCTION

SHEET 2 OF 8 SHEETS
CONTRACT No. PW 6570
ASSIG. NO. A.O. 2306
DATE JUNE 23, 1975